


**CERTIFIED RECORD OF LAND CORNER MONUMENTATION**

**HISTORY OF ORIGINAL CORNER ESTABLISHMENT:**  
Corner not previously established

T 1 N R 35 E P-04

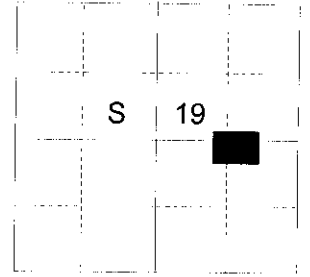

**DESCRIPTION OF CORNER EVIDENCE FOUND:**  
None.

**DESCRIPTION OF MONUMENT AND ACCESSORIES I ESTABLISHED  
TO PERPETUATE THE ORIGINAL LOCATION OF THIS CORNER:**


At position established by survey, I set a 5/8" x 30" iron rebar with a 2 1/2" aluminum cap marked as shown below, 30 inches in the ground, from which:

An 11 inch Douglas Fir bears North 46° East, a distance of 16.55 feet, marked CE1/16 S19 BT.  
A 15 inch Douglas Fir bears North 26° West, a distance of 8.55 feet, marked CE1/16 S19 BT.

I set a steel fencepost approximately 2 ft. North of corner monument.

I hereby certify that the corner was perpetuated on September 9, 2013.

REGISTERED  
PROFESSIONAL  
LAND SURVEYOR

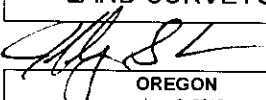

OREGON  
June 2, 2010  
JEFFREY S. HSU  
83571

Renewal Date: June 30, 2015

BAGETT - GRIFFITH & BLACKMAN

T1N R35E  
E 1/16  
C ——— C  
S19  
2013  
OPLS 83571

I used a steel tape and magnetic compass in the establishment of the bearing trees. Magnetic declination used was 16° East. Bearings are to a washer marked OPLS 83571 in the lower BT blaze.

**RECEIVED BY**  
Umatilla County Surveyor  
Date: 9/20/2013  
Rec'd By: [Signature]  
No.: 13-521-B