


CERTIFIED RECORD OF LAND CORNER MONUMENTATION

HISTORY OF ORIGINAL CORNER ESTABLISHED:

Corner not previously established.

T 1 N R 35 E Q-19

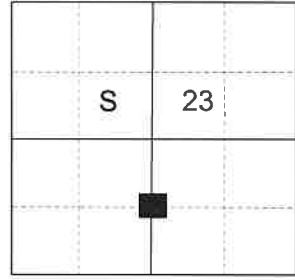

DESCRIPTION OF CORNER EVIDENCE FOUND:

None found.

BLM approx. corner lies approx. 7 ft. Northwesterly

DESCRIPTION OF MONUMENT AND ACCESSORIES I ESTABLISHED TO MONUMENT THE ORIGINAL LOCATION OF THIS CORNER:

At position by Survey I set a 5/8" x 30" iron pin, 28" in the ground, with 2 1/2" aluminum cap marked as shown below, in a collar of stone 1' diam., from which:

NEW BEARING OBJECTS:

A 6" Ponderosa Pine bears North 74° East, a dist. of 12.05 ft., marked CS 1/16 S23 BT.
A 12" Ponderosa Pine bears South 14° West, a dist. of 83.15 ft., marked CS 1/16 S23 BT.


Set steel fence post approx. 0.50 ft. West

I hereby certify that the corner was monumented on September 21, 2021.

Witnesses: Kyle Tucker, Emmitt Ambert



Renewal Date: June 30, 2023

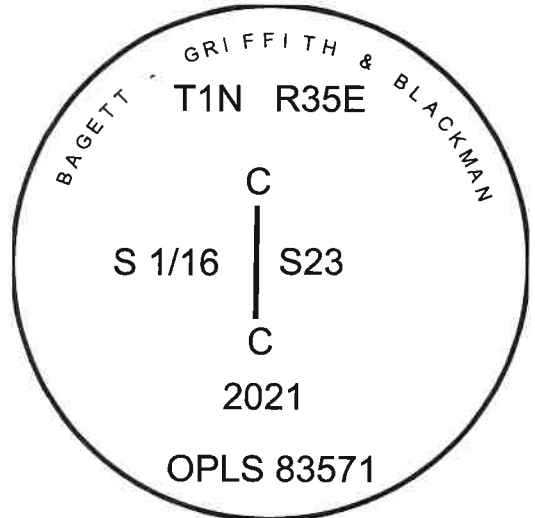

I used a steel tape and magnetic compass in the establishment of the new accessories. I used 14° East declination. Distances are to a 60d spike driven into the right side of the root crown of the bearing trees. Bearings are to a brass washer marked OPLS 83571 is attached to the BT blaze of the new bearing trees.