

CERTIFIED RECORD OF LAND CORNER MONUMENTATION

HISTORY OF ORIGINAL CORNER ESTABLISHMENT:

Corner originally established by Currin and Noland under GLO contract dated May 4, 1887. Surveyor General record states:


Set basalt stone 20x8x7 ins. 16 ins. in the ground for cor to Secs. 22, 23, 26 and 27, marked with 2 notches on S and E edges, from which:
A Pine 30 ins. diam. bears S40E 100lks. dist. marked T1N R35E S26 BT.

In Survey Number H-225-B (also recorded as 84-034-B and 02-66-B), Dave Krumbein finds mound of stone and sets brass cap.

Corner recovered and accepted by Gary Wagner in survey 05-181-B

Corner recovered and accepted by William R. Wells in survey number 06-509-B.

T 1 N R 35 E R-17

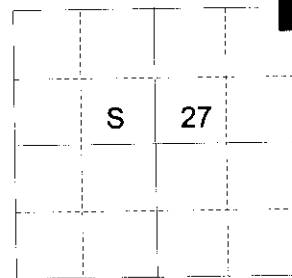

DESCRIPTION OF CORNER EVIDENCE FOUND:

Found 2 1/2" x 30" iron pipe with 2 1/2" brass cap marked as shown below, loose, lying horizontally on ground next to mound of stone. Corner position reestablished by record distances of Survey Number 06-509-B to the quarter corner common to Section 26 and 27 (as set by said survey) and the Section corner common to Sections 21, 22, 27 and 28. Position falls in center of mound of stone. From which:

A 22 inch Ponderosa Pine bears North 42° West, a distance of 16.85 feet. No blaze marks visible, but has a bearing tree tag marked South 45°50' East 16.1 feet to corner monument. Tag stamped PLS 933.

DESCRIPTION OF MONUMENT AND ACCESSORIES I ESTABLISHED TO PERPETUATE THE ORIGINAL LOCATION OF THIS CORNER:

At the position, I reset the monument, 12 inches in the ground to bedrock, in a mound of stone 3 ft. in diameter, from which, new bearing trees:

- A 14 inch Ponderosa Pine bears South 10° East, a distance of 36.50 feet, marked T1N R35E S26 BT.
- A 15 inch Douglas Fir bears South 36° West, a distance of 62.75 feet, marked T1N R35E S27 BT.
- A 17 inch Ponderosa Pine bears North 23° East, a distance of 36.60 feet, marked T1N R35E S22 BT,


I set a steel fencepost approx. 1 foot East of corner monument. Raised mound of stone alongside.

I hereby certify that the corner was perpetuated on November 8, 2012.

Witness: Rick Robinson



Renewal Date: June 30, 2013

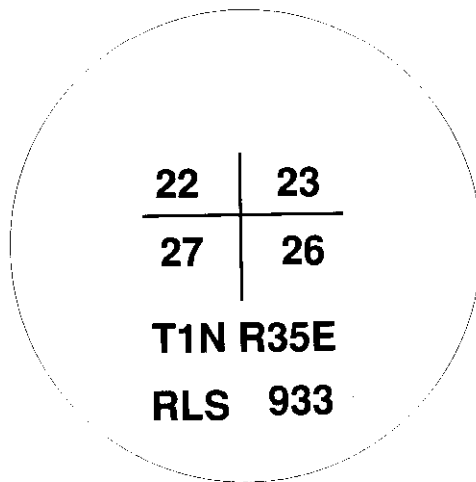

RECEIVED BY
Umatilla County Surveyor
Date: 12/14/2012
Rec'd By: J. Oles
No.: 12-145-B

I used a steel tape and magnetic compass in the recovery of the bearing tree and establishment of new tree. I used 16° East magnetic declination and the bearings and distances are to the center of root crown on old bearing tree. Distances are to a 60d spike in the right hand side of the new trees. Bearing is to a brass washer marked OPLS 83571 in the lower BT blaze.