


Index
File No. R-17
T IN R. 35E
Merid. WILLAMETTE

CORNER RECORD (SEARCH)

(Ref. FSM 7151.4)

Tract or Survey No. _____ Cor. No. _____
R.D. WALLA WALLA County UMATILLA
S.F. UMATILLA State OREGON

CORNER DIAGRAM:

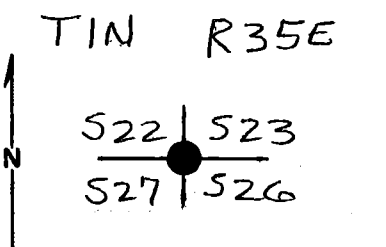

DESCRIBE CORNER MONUMENT FOUND

BRASS CAPPED IRON PIPE IN A MOUND OF STONES. CAP IS PROTRUDING 18"

DESCRIBE BEARING TREES OR OTHER OFFICIAL ACCESSORIES FOUND

ORIGINAL 30" PINE IS A DELAYED, SAWN PINE STUMP. NO MARKS REMAIN. BEARS S40°E, 66° FT.
THERE ARE TWO OTHER TREES WITH BT

PHOTO IDENTIFICATION DATA

Photo No. _____
Filed At. _____
Object Ident. _____
Ident. By _____
Signature

DESCRIBE CORNER LOCATION RELATIVE TO NEAR-BY FEATURES, ALSO HOW TO REACH CORNER

SIGNS & SMALL HEALED BLAZES. ONE IS A POND. PINE TO NW & A FIR TO SE.

PLANE COORDINATE POSITION DATA

State _____ Zone _____
X _____
Y _____
Estab. By _____
Agency

Signature

Title

Division

Headquarters

Date

FS-7100-52 (3/68)

Dennis L. Gaylord PLS 1636 S.O. APRIL 13, 1995

CORNER RECORD (PERPETUATION)

MONUMENT: DESCRIBE NEW MONUMENT SET, OR WORK DONE TO PRESERVE EXISTING MONUMENT

9

ACCESSORIES : DESCRIBE NEW BT's WITNESS OBJECTS ETC. ESTABLISHED, OR WORK DONE TO PRESERVE EXISTING EVIDENCE

10

Work Done By _____ Title _____ Date _____ State Registration No. or Agency _____

11

Certified Cor. Record Prepared ? Yes No Filed At: _____ Date _____

REMARKS

12

13

Index File No. T. R. M. Tract or Surv. No. Cor.

USDA-FOREST SERVICE

B L M

Index File No. R-17


CORNER RECORD (SEARCH)
(Ref. FSM 7151.4)

Tract or Survey No. _____ Cor. No. R-17

T 1N R. 35E R.D. _____ County _____

Merid. Willamette N.F. _____ State Oregon

CORNER DIAGRAM

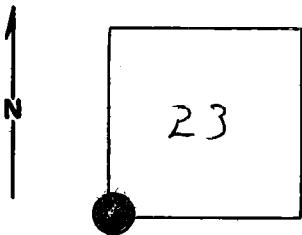

DESCRIBE CORNER MONUMENT FOUND

Brass cap set by Bureau of Indian Affairs,
Rock mound on base of brass cap,

DESCRIBE BEARING TREES OR OTHER OFFICIAL ACCESSORIES FOUND

Remnant of BIT, south of corner,
(Brass cap found B.C.C) TAG 1-77

PHOTO IDENTIFICATION DATA

Photo No. _____
Filed At. _____
Object Ident. _____
Ident. By _____

PLANE COORDINATE POSITION DATA

State _____ Zone _____
X _____
Y _____
Estab. By _____
Agency _____

DESCRIBE CORNER LOCATION RELATIVE TO NEAR-BY FEATURES, ALSO HOW TO REACH CORNER

Location tag on road west of corner
Location tag on trail south of corner

Signature

Hollis

Title

Division

Headquarters

BuKar, Orai

Date

8/11/71

7100-52-(3/68)

C

6

7

8

2

3

4

5

CORNER RECORD (PERPETUATION)

MONUMENT : DESCRIBE NEW MONUMENT SET, OR WORK DONE TO PRESERVE EXISTING MONUMENT

ACCESSORIES : DESCRIBE NEW BT's WITNESS OBJECTS ETC. ESTABLISHED, OR WORK DONE TO PRESERVE EXISTING EVIDENCE

Work Done By _____ Title _____ Date _____ State Registration No. or Agency _____
Certified Cor. Record Prepared ? Yes No Filed At: _____ Date _____

REMARKS

Index File No. T. R. M. Tract or Surv. No. Cor.