

**OREGON CORNER RESTORATION FORM**

Section 21 Township 1N Range 35E  
 County Umatilla Date: November 8, 2007

Corner Designation: 1N35R9

Condition Report Only  
 Not found  
 Remonumented  
 Unrecorded  
 Surveyed in  
 Referenced out

Corner to sections 20, 21, 28, and 29, T1N, R35E,  
 W.M., Umatilla County, Oregon.



Previous Renewals / Surveys, etc.

This corner was originally set by James Currin and James Noland under special instructions dated May 4, 1889. Their record reads: Set basalt stone 14x12x10 ins., 8 ins. in the ground for cor. to secs. 20, 21, 28 & 29, marked with 2 notches on S. and 4 Notches on E. edges, from which a Tamarack, 12 ins. in diam. brs. N35°E 13 lks. dist., marked T1N S21 BT; a Black Pine 10 ins. in diam. brs. S75°E 6 lks. dist., marked R35E S28 BT; a Fir 20 ins. in diam. bears S20°W 21 lks. dist., marked T1N S29 BT; a Tamarack 12 ins. in diam. bears N70°W 29 lks. dist., marked R35E S20 BT. Mr. Don Staebler, under survey F-23-Ax stated, found basalt stone, agrees with bearing trees in the S.W. and N.W. quad.

Monument and Accessories found: ( condition and source )

A basalt stone 18x10x5 inches, buried 16 inches in the ground with questionable marking on the edges and a decayed survey stake and flagging along side. The original Tamarack bearing tree with visible scribing, dead and down, to the northwest. The fir to the southwest is almost completely decayed.

**DIAGRAM**

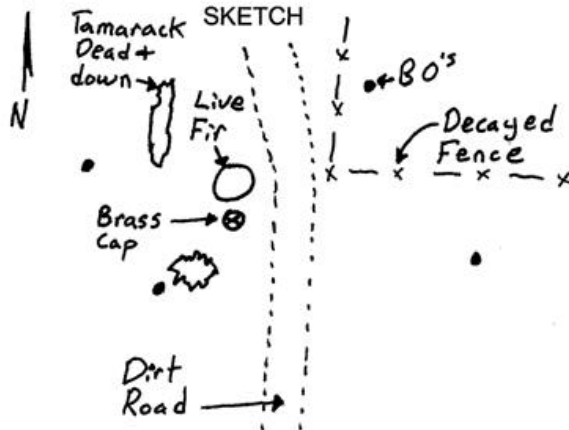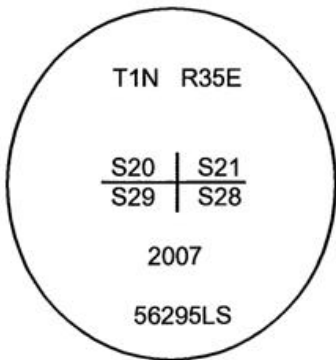

**MONUMENT (S) AND ACCESSORIES SET (Procedures and Description)**

I confirmed the location of the stone by ties to monuments that Mr. Staebler set in 1969 and the original bearing trees and, at the position of the original stone, I set a 1-1/2" x 30" galvanized iron pipe with a 2 1/4" brass cap stamped as shown in the diagram above.

For references, I set four, 5/8" by 24" rebars with 1 1/8" orange plastic caps attached, stamped WTS and 56295LS as described below:

- an iron rebar bears N28°16'18"E, 27.87 feet ;
- an iron rebar bears N86°02'11"W, 37.17 feet;
- an iron rebar bears S69°35'06"E, 51.15 feet;
- an iron rebar bears S28°10'37"W, 18.24 feet;

The monument and references were tied using a Trimble 5601 Robotic total station.

Location and comments

Compass Declination

Surveyors Seal

RECEIVED BY:  
 Umatilla County Surveyor  
 Date: 2-08  
 Rec'd By: KK  
 No. 08-043-B

Firm / Agency  
 Witness Tree Surveying  
 Address  
 P.O. Box G  
 Pilot Rock, Or. 97868  
 Party Chief  
 Stephen K. Haddock

REGISTERED  
 PROFESSIONAL  
 LAND SURVEYOR

*Stephen K. Haddock*

OREGON  
 JULY 9, 2001  
 STEPHEN K. HADDOCK  
 56295LS

RENEWAL DATE 6-30-09