

CERTIFIED RECORD OF LAND CORNER MONUMENTATION

HISTORY OF ORIGINAL CORNER ESTABLISHED:

Corner not previously established.

T 1 N R 35 E T-16

S	27
	■

DESCRIPTION OF CORNER EVIDENCE FOUND:

Boise Cascade Location tag on fence post bears approx. 24 ft. South West.

DESCRIPTION OF MONUMENT AND ACCESSORIES I ESTABLISHED TO PERPETUATE THE ORIGINAL LOCATION OF THIS CORNER:

At position determined by survey, I set a 5/8" x 30" iron pin with 2 1/2" aluminum cap, marked as shown below, 25" in the ground, From which:


NEW BEARING TREES:

A 5" White Fir bears North a dist. of 12.75 ft. marked CE 1/16 S27 BT.
A 4" White Fir bears North 81° West a dist. of 14.85 ft. marked CE 1/16 S27 BT.


Set a steel fence post approx. 1 foot West of the corner monument.

I hereby certify that the corner was perpetuated on July 2, 2018.

Witness: Kyle Tucker, Ryan Skeen

REGISTERED PROFESSIONAL LAND SURVEYOR	
	OREGON June 2, 2010 JEFFREY S. HSU 83571

Renewal Date: June 30, 2019

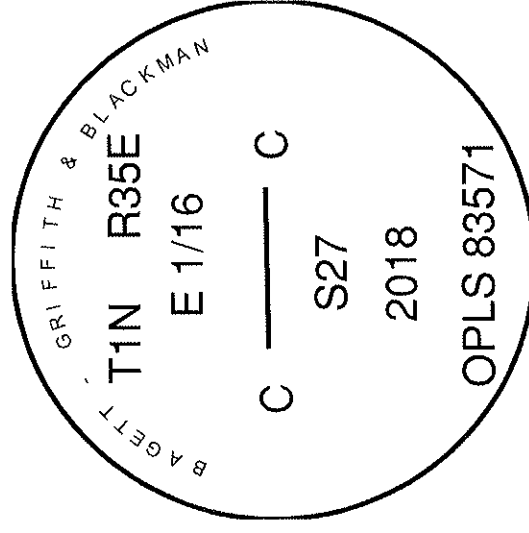

I used a steel tape and magnetic compass in the establishment of the new accessories. I used 13° East declination, the distances are to a 60d spike driven into the right side of the root crown of the bearing trees. A brass washer marked OPLS 83571 is attached to the BT blaze of the new bearing trees.

18-056-B