


CERTIFIED RECORD OF LAND CORNER MONUMENTATION

HISTORY OF ORIGINAL CORNER ESTABLISHED:

Corner originally established under GLO Special Contract dated May 4, 1887, executed by James P. Currin and James E. Noland. Surveyor General field notes state:

T 1 N R 35 E V-07

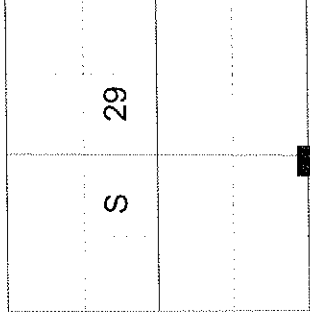

Set post 3 ft. long, 3 ins. square, 24 ins. in the ground for 1/4 S. cor marked 1/4 S on N. face, from which:

- A fir, 16 ins. diam. bears N51° W, 125 lks. dist. marked 1/4 S. BT.
- A pine 25 ins. diam. bears S65°W, 76 lks. dist. marked 1/4 S BT.

Corner monumented at proportionate position by Hollingworth in Survey S-124-B. Umatilla County Monumentation record states:
Set 5/8" x 30" capped iron rod marked "Oregon State Parks".
7' fiberglass post 2.0' South of iron rod.
10" Tamarack S8°E, 21.1' to center, scribed "N1/4 S32 BT".
12" fir N53°W, 33.8' to center, scribed "S1/4 S29 BT RS691".

Survey S-124-B states found 3/8" iron rod S51°57'13"W, 25.82'

DESCRIPTION OF CORNER EVIDENCE FOUND:

Found 5/8" iron pin with 1 1/2" aluminum cap marked "OREGON STATE PARKS", flush with ground.

Carsonite post bears South 2 ft.

DESCRIPTION OF MONUMENT AND ACCESSORIES I ESTABLISHED TO PERPETUATE THE ORIGINAL LOCATION OF THIS CORNER:


From the iron pin monument,

NEW BEARING OBJECTS:

- An 11" Ponderosa Pine bears North 65° East, a distance of 7.60 feet, marked 1/4 S29 BT.
- A 6" Lodgepole Pine bears South 34° East, a distance of 6.70 feet, marked 1/4 S32 BT.
- A 6" Lodgepole Pine bears South 87° West, a distance of 9.65 feet, marked 1/4 S32 BT.
- A 5" White Fir bears North 15° West, a distance of 7.15 feet, marked 1/4 S29 BT.

I certify this corner was perpetuated October 16, 2018. Corner falls approx 8 ft. North of a fence corner.

Witness: Kyle Tucker

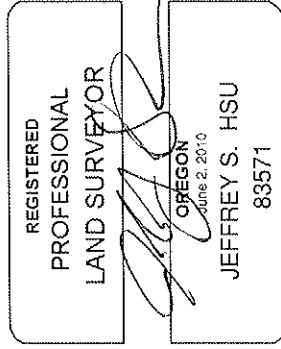

Renewal Date: June 30, 2019

I used a steel tape and magnetic compass in the establishment of the new accessories. I used 13° East declination. The distances are to a 60d spike driven into the side of the root crown of the bearing trees. A brass washer marked OPLS 83571 is attached to the BT blaze of the new bearing trees.

V-07

18-108-R