

CERTIFIED RECORD OF LAND CORNER MONUMENTATION

Page 1 of 2

V - 17
DIAGRAM

History of original corner establishment:

The original corner was established by James P. Currin & James E. Noland on June 28, 1887, under special GLO contract, as follows:

T1N R35E
S27/S26
S34/S35
PLS 1636
2001

Set a post 4 ft. long, 4 inches square, 24 inches into the ground for corner to sections 26, 27, 34 and 35, properly marked, surrounded by a mound of stone.

On June 22, 1895, Manius Buchanan, under GLO contract No. 635, destroyed the corner established by Currin & Noland, and set a post 3 feet long, 4 inches square, 24 inches into the ground, properly marked, for the corner to sections 26, 27, 34 and 35, from which:

- A 20" fir bears S53°E, 29 links (19.14 feet).
- A 17" fir bears S71°W, 51 links (33.66 feet).
- A 22" fir bears N63°W, 32 links (21.12 feet).

Buchanan's supplemental notes, resulting from his retracements based on problems with his initial survey revealed by an audit by the government inspector, indicate a fourth bearing tree; a 13" fir which bears N1°E, 10 links (6.60 feet). The corner established by Currin & Noland in 1887, and destroyed by Buchanan, bears 15 links east of a point 50 links north of the new corner established by Buchanan. Buchanan indicates he destroyed the marks on the bearing trees for the Currin & Noland corner, although there are none recorded in the Currin & Noland field notes.

As noted on Umatilla County Surveyor drawing H - 225 - C, dated June, 1971, David H. Krumbein, PLS 933, found at this corner a 4 x 4 post, fallen over, and he set a brass cap.

Corner evidence recovered:

There is no brass capped monument in evidence at this corner.

At the corner point I find a 60 penny nail, with old red flagging tied to the top, with the top set 2 inches below the ground surface, from which:

A 26" Douglas-fir with a healed blaze bears N1°E, 6.6 feet to the face. The original corner post is lying alongside this bearing tree. The original corner post is 4" x 4" x 30" long and has fragmentary scribing visible on one face. The roots of a decayed fir bears S53°E, 19.1 feet. The roots of a decayed fir bears S71°W, 33.7 feet. The roots of a badly decayed fir bears N63°W, 21.1 feet. No marks were recovered on the remains of these three decayed original fir bearing trees. From the position of the original Currin and Noland corner, I find the following bearing tree evidence: A badly decayed stump, specie indeterminate, with reverse scribes, "BT", visible on a piece of the stump, in the northeast quadrant. A sawn and decayed Western Larch stump with partially healed double blazes, the lower blaze having horizontal axe marks with scribes chopped out, in the southeast quadrant. A sawn White Fir stump, with long butt lying alongside, with a partially healed blaze, scribing chopped out, in the northwest quadrant. There are no stones anywhere in this area, contrary to what is recorded in the Currin and Noland notes.

Monument and accessories established to perpetuate the original position of this corner:

At the point occupied by the 60 penny nail, I set a 1" x 30" flared, galvanized iron pipe 28" into the ground. A 2 1/2" brass cap attached to the top of the pipe is marked as shown in the diagram above, from which:

- A 6" White Fir, scribed "T1N R35E S35 BT", bears S56°E, 76.1 feet.
- A 8" Douglas-fir, scribed "T1N R35E S34 BT", bears S62° 30'W, 55.7 feet.
- A 13" Douglas-fir, scribed "T1N R35E S27 BT", bears N32° 30'W, 89.9 feet.

The new bearing trees are scribed on double blazes and have a 3/4" brass washer, marked "PLS 1636", nailed flush to the bottom of the lower blaze. An east-west barbed wire fence bears north, 2 feet from the corner. I placed a "Bearing Object" sign above the blaze of the original bearing tree to the northeast.

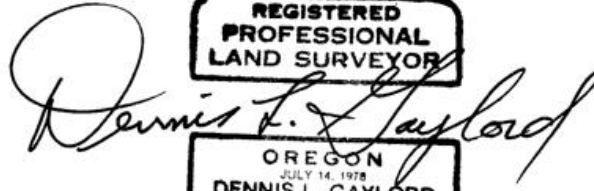
Umatilla County Surveyor
Date 08-01
Rec'd By JK

CERTIFIED RECORD OF LAND CORNER MONUMENTATION

V - 17, T. 1 N., R. 35 E.

Page 2 of 2

I hereby certify the above corner point was perpetuated as hereon described on October 18, 2001.
Witness: David A. Schlaich, PLS 2308 . Magnetic declination set in compass: 18° E.


**REGISTERED
PROFESSIONAL
LAND SURVEYOR**
OREGON
JULY 14, 1978
DENNIS L. GAYLORD
1636

Renews June 30, 2003

Recorded at the office of County Surveyor, County of Umatilla, State of Oregon, on _____, 2001

RECEIVED BY
Umatilla County Surveyor
Date 10-01
Rec'd By KE
No. 11-157-R