

Index File No. V-17

CORNER RECORD (SEARCH)

(Ref. FSM 7151.4)

Tract or Survey No. _____ Cor. No. _____


T 1N R. 35E

R.D. WALLA WALLA County UMATILLA

Merid. WILLAMETTE

N.F. UMATILLA State OREGON

CORNER DIAGRAM

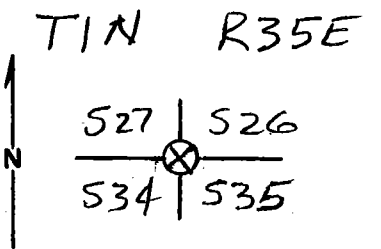

DESCRIBE CORNER MONUMENT FOUND

6" NAIL BURIED 2" INTO GROUND.

DESCRIBE BEARING TREES OR OTHER OFFICIAL ACCESSORIES FOUND

ORIG. 13" FIR IS LIVE W/ HEALED BLAZES & 1945 K-TAG. BEARS N10°E, 6.6 FT.
 DECAYED STUMP BEARS S53°E, 19.14 FT.
 DECAYED STUMP BEARS S71°W, 33.66 FT.
 NW BT IS GONE.

PHOTO IDENTIFICATION DATA

Photo No. _____
 Filed At. _____
 Object Ident. _____
 Ident. By _____
Signature

DESCRIBE CORNER LOCATION RELATIVE TO NEAR-BY FEATURES, ALSO HOW TO REACH CORNER

18" SOUTH OF E-W FENCE,

PLANE COORDINATE POSITION DATA

State _____ Zone _____
 X _____
 Y _____
 Estab. By _____
Agency

Signature Dennis L. Gaylord Title _____ Division PLS 1636 Headquarters S.O. Date APR. 13, 1995 FS-7100-52 (3/68)

CORNER RECORD (PERPETUATION)

MONUMENT: DESCRIBE NEW MONUMENT SET, OR WORK DONE TO PRESERVE EXISTING MONUMENT.

ACCESSORIES : DESCRIBE NEW BT'S WITNESS OBJECTS ETC. ESTABLISHED, OR WORK DONE TO PRESERVE EXISTING EVIDENCE

Work Done By _____ Title _____ Date _____ State Registration No. or Agency _____

Certified Cor. Record Prepared ? Yes No Filed At: _____ Date _____

REMARKS


Index File No. T. R. M. Tract or Surv. No. Cor.

LAND CORNER RECORD

LL 5680-2

1. T 1N R 35E No. V17 Cor. Sec. Mer. Will State Ore (Rectangular) N. F. Umatilla Dist. Pend 3

2. Corner Status

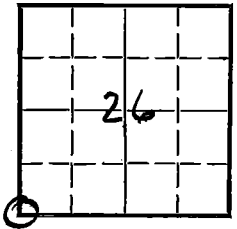

7. Photo Identification

Photo No. _____
Ident. By: _____

8. Plane Coordinate Position Data

State _____ Zone _____
X _____
Y _____
Estab. By _____
Field Book No. _____
Where Filed _____

9. Evaluation

Authentic _____
Needs Verif. X Monument no
Re-estab. _____ Survey _____
Land Status private

3. Original Description _____ Vol. 388 Page 258 Where Recorded BLM Portland

4. Description of Corners: a fir post 3' long 4" sq. 24" in the ground, marked T1N S26 on NE, R35E S35 on SE, S34 on SW, S27 on NW faces with 1 notch on S & 2 on E edges from which a fir 20" dia bears S53E 29 lks marked T1N, R35E S35 BT, a fir 17" dia bears S71°W 51 lks. marked T1N, R35E S34 BT a fir 22" dia bears N63°W 32 lks marked T1N, R35E, S27 BT

5. Investigation Notes:

By plotting our road traverse for the Horseshoe Ridge Rd N-208 along with the Sec. corn. ties that we already had we determined at which station the section line would crosses & by scaling determined the dist. to the cor. We then went to the field at this station & by compass & pacing we were able to locate a 4"x4" wood post 3' long lying on the ground. The post was marked T1N S26 on one face, R35E S35 on one face, S27 on one face & S34 on the other face.

The post is beginning to rot badly

No other evidence was found.

6. Signed R. C. Holmes Title Engineering Asst Date 8-10-62

PERPETUATION RECORD

10. Monument:

11. Accessories

Field Book _____ Page _____

12. Set By _____ Title _____
License _____ Agency _____ Date _____

13. Recorded By: _____ Volume _____ Page _____
(Agency) _____
(Date) _____ (City) _____ (County) _____ (State) _____

14. Remarks:

V-17.