

CERTIFIED RECORD OF LAND CORNER MONUMENTATION


HISTORY OF ORIGINAL CORNER ESTABLISHED:

Corner originally established by J. Currin and J. Noland under GLO contract dated May 4th, 1887. Surveyor General field notes state:

Set Basalt Stone 12 x 10 x 8 ins., 8 ins. in the ground for cor. to secs. 28, 29, 32, and 33 marked with 1 notch on S and 4 notches on East edges from which:

- A Pine 10 ins. diam. bears N 44° E 18 lks dist. marked T1N S28 BT.
- A Pine 12 ins. diam. bears S 67° E 22 lks dist. marked R35E S33 BT.
- A Pine 10 ins. diam. bears S 55° W 11 lks dist. marked T1N S32 BT.
- A Pine 12 ins. diam. bears N 75° W 14 lks dist. marked R35E S29 BT.
- A Fir 6 ins diam bears S 69° W 38 lks dist

T 1 N R 35 E V-09

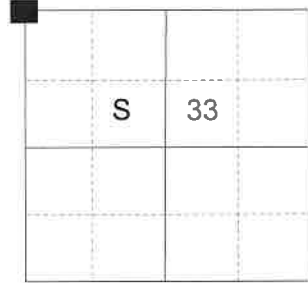

Corner monumented by W. E. O. Criger in Survey 06-62-Ax, dated 1950. Umatilla County Records state:
Found by Bearing Trees-Ref. Surveyed, Staked, and Platted. (Circle symbol depicts ½" pipe set.)

Corner found by Donald Staebler in Survey F-24-Ax, dated 1969. Umatilla County Records state:
Found ½" pipe in mound of stones- No original bearing trees found. Scribed new trees:
A 14" fir bears North 88° East a distance of 12.4 ft.
A 12" fir bears South 21°30' East a distance of 33.6 ft

DESCRIPTION OF CORNER EVIDENCE FOUND:

Found a ½" I.D. (3/4" O.D) iron pipe, 12" above ground, from which:
A 24" Douglas Fir bears North 84° East a dist. of 12.40 ft., alive and vigorous with healed blaze.

East/West fence bears North approx. 6".

DESCRIPTION OF MONUMENT AND ACCESSORIES I ESTABLISHED TO PERPETUATE THE ORIGINAL LOCATION OF THIS CORNER:

From the iron pipe monument:

NEW BEARING OBJECTS:

- A 5" Douglas Fir bears South 70° East a dist. of 42.10 ft., marked T1N R35E S33 BT.
- An 8" Douglas Fir bears South 23° West a dist. of 8.80 ft., marked T1N R35E S32 BT.
- A 9" Lodgepole Pine bears North 35° West a dist. of 15.60 ft., marked T1N R35E S29 BT.

I hereby certify that the corner was perpetuated on September 12, 2019.
Witness: Kyle A. Tucker

I used a steel tape and magnetic compass in the establishment of the new accessories. I used 13° East declination, the distances are to a 60d spike driven into the right side of the root crown of the bearing trees. A brass washer marked OPLS 83571 is attached to the BT blaze of the new bearing trees.



Renewal Date: June 30, 2021