


CERTIFIED RECORD OF LAND CORNER MONUMENTATION

HISTORY OF ORIGINAL CORNER ESTABLISHED:

Corner originally established under GLO Special Contract dated May 4, 1887, executed by James P. Currin and James E. Noland. Surveyor General field notes state:

T 1 N R 35 E X-09

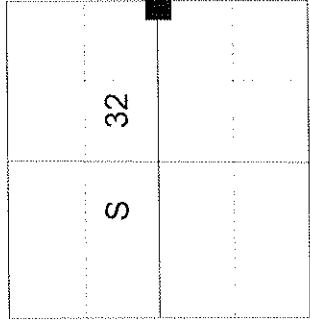

Set post 3 ft. long, 3 ins. square, 24 ins in the ground for 1/4 Sec. Cor. marked 1/4 S on W. face, from which:
A Pine 6 ins. diam. brs. S10°East, 29 lks. dist. marked 1/4 S. BT.
A Tamarack 10 ins. diam., bears N73°W, 72 lks. dist. marked 1/4 S. BT.

Corner monumented at proportionate position by William Wells in 1983. Umatilla County Monumentation record 85-11-A states:

Set 2x30" iron pipe with brass cap 24" in the ground from which:
A 9" Western Larch bears S55°W 9.1 feet scribed 1/4 S32 BT.
A 10" Ponderosa Pine bears S51°E 55.7 feet scribed 1/4 S33 BT.

DESCRIPTION OF CORNER EVIDENCE FOUND:

Found 2" iron pipe with 2" brass cap, 4" above ground, marked as shown below, from which:
A 16" Ponderosa Pine bears South 51° East, a distance of 55.70 feet, alive and vigorous with healed blaze.
A 10" Western Larch stump bears South 55° West, a distance of 9.10 feet, with BT scribes visible.

DESCRIPTION OF MONUMENT AND ACCESSORIES I ESTABLISHED TO PERPETUATE THE ORIGINAL LOCATION OF THIS CORNER:



From the iron pipe monument,

NEW BEARING OBJECTS:

A 4" Western Larch bears North 76° East, a distance of 23.30 feet, marked 1/4 S33 BT.
A 10" Lodgepole Pine bears South 45° West, a distance of 23.95 feet, marked 1/4 S32 BT.
A 12" Douglas Fir bears North 14° West, a distance of 38.00 feet, marked 1/4 S32 BT.

I certify this corner was perpetuated October 5, 2018.

Witness: Kyle Tucker

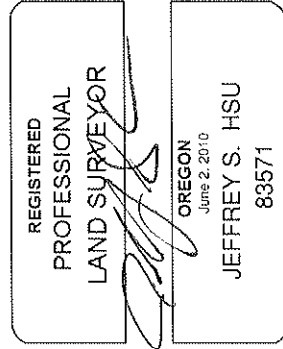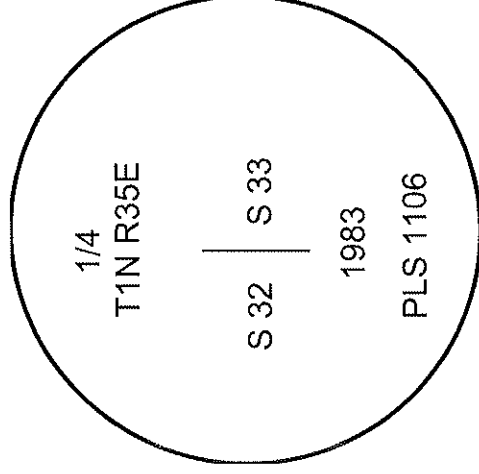

Renewal Date: June 30, 2019

I used a steel tape and magnetic compass in the establishment of the new accessories. I used 13° East declination. The distances are to a 60d spike driven into the side of the root crown of the bearing trees. A brass washer marked OPLS 83571 is attached to the BT blaze of the new bearing trees.

X-09

18-107-R