

USDA-FOREST SERVICE

Index File No. Z-01
T 1N R. 36E
Merid. W.M.

CORNER RECORD (SEARCH) : Tract or Survey No. _____ Cor. No. _____
(Ref. FSM 7151.4)
R.D. WALLA WALLA County UMATILLA
N.F. UMATILLA State OREGON

CORNER DIAGRAM



DESCRIBE CORNER MONUMENT FOUND

FND BLM BRASS CAP RISING 2" ABOVE GROUND

DESCRIBE BEARING TREES OR OTHER OFFICIAL ACCESSORIES FOUND

28" D. FIR BEARS N79°W, 52 LKS., 34.3 FT.,
B&S TIN R35E S36 SC BT.

12" D. FIR BEARS N60°W, 37 LKS. 24.4 FT., BLAZE HEALED
26" D. FIR BEARS N17°E, 31 LKS., 20.5 FT., BLAZE HEALED.

PHOTO IDENTIFICATION DATA

Photo No. _____
Filed At. _____
Object Ident. _____
Ident. By _____
Signature

PLANE COORDINATE POSITION DATA

State _____ Zone _____
X _____
Y _____
Estab. By _____
Agency

DESCRIBE CORNER LOCATION RELATIVE TO NEAR-BY FEATURES, ALSO HOW TO REACH CORNER

3032 CROSSES WEST LINE OF SEC 31 400'
NORTH OF CORNER

Signature

Title

LS 1848

Division

Headquarters

Date

6-21-85

7100-52 (3.68)

CORNER RECORD (PERPETUATION)

MONUMENT: DESCRIBE NEW MONUMENT SET, OR WORK DONE TO PRESERVE EXISTING MONUMENT

NONE

ACCESSORIES : DESCRIBE NEW BT'S WITNESS OBJECTS ETC. ESTABLISHED, OR WORK DONE TO PRESERVE EXISTING EVIDENCE

SET STEEL FENCE POST 3' EAST

ATTACHED SIGNS TO POST & BT'S . PAINTED RED BANDS

Work Done By DAVE SCOTT Title SURVEYOR Date 6-21-85 State Registration No. LS 1844
or Agency

Certified Cor. Record Prepared ? Yes No Filed At: _____ Date _____

REMARKS

Index File No. Z-01 T. 1N R. 36E M. WILLAMETTE Tract or Surv. No.

Cor. 36/31 13

USDA-FOREST SERVICE

Index
File No. Z-1

CORNER RECORD (SEARCH)

(Ref. FSM 7151.4)

Tract or
Survey No. _____

Cor.
No. _____

T IN R. 36E


R.D. WALLA WALLA County UMATILLA

Merid. WILLAMETTE

N.F. UMATILLA

State OREGON

CORNER DIAGRAM

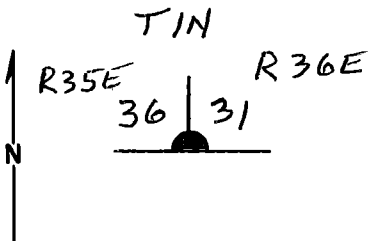

DESCRIBE CORNER MONUMENT FOUND

1983 BLM BRASS CAP

DESCRIBE BEARING TREES OR OTHER OFFICIAL ACCESSORIES FOUND

PHOTO IDENTIFICATION DATA

Photo No. _____

Filed At. _____

Object Ident. _____

Ident. By _____

Signature

PLANE COORDINATE POSITION DATA

State _____ Zone _____

X _____

Y _____

Estab. By _____

Agency

Signature

BILL WELLS

Title

Division

Headquarters

Date

Nov. 1994

FS-7100-52 (3/68)

CORNER RECORD (PERPETUATION)

MONUMENT: DESCRIBE NEW MONUMENT SET, OR WORK DONE TO PRESERVE EXISTING MONUMENT

ACCESSORIES : DESCRIBE NEW BT'S WITNESS OBJECTS ETC. ESTABLISHED, OR WORK DONE TO PRESERVE EXISTING EVIDENCE

Work Done By _____ Title _____ Date _____ State Registration No. _____
or Agency _____

Certified Cor. Record Prepared? Yes No Filed At: _____ Date _____

REMARKS

Index File No. T. R. M. Tract or Surv. No. Cor.