


Index
 File No. P-05 CORNER RECORD (SEARCH) Tract or _____ Cor. _____
 (Ref. FSM 7151.4) Survey No. _____ No. _____
 T IN R. 36E R.D. WALLA-WALLA County WATILLA
 Merid. WILLAMETTE N.F. WATILLA State OREGON

CORNER DIAGRAM

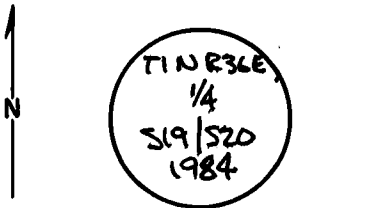

DESCRIBE CORNER MONUMENT FOUND

3 1/4" BRASS CAP SET IN CONCRETE FLUSH WITH GROUND

DESCRIBE BEARING TREES OR OTHER OFFICIAL ACCESSORIES FOUND

1 3/2" PONDEROSA PINE BEARS S59 3/4° E ~ 349 LKS 230 FT
 BLAZED & SCRIBED 1/4 S20 BT

13" WHITE FIR BEARS S32 3/4° W ~ 219 LKS - 144 FT
 BLAZED & SCRIBED 1/4 S19 BT

DESCRIBE CORNER LOCATION RELATIVE TO NEAR-BY FEATURES, ALSO HOW TO REACH CORNER

3/4 MILE SOUTH OF INTERSECTION OF 3030 & 3030-050
 APPROX 900 FT WEST OF ROAD 3030-050 ON RIDGE TOP

PHOTO IDENTIFICATION DATA

Photo No. _____
 Filed At. _____
 Object Ident. _____
 Ident. By _____
 Signature

PLANE COORDINATE POSITION DATA

State _____ Zone _____
 X _____
 Y _____
 Estab. By _____
 Agency

Signature
B. Sutton

Title
 PLS 1848

Division

Headquarters

Date
 11-19-84

7100-52-(3/68)

CORNER RECORD (PERPETUATION)

MONUMENT : DESCRIBE NEW MONUMENT SET, OR WORK DONE TO PRESERVE EXISTING MONUMENT

SET STEEL FENCE POST WITH 54-2 & 54-4 SIGNS ATTACHED -
3 FT NORTH OF CORNER MONUMENT

ACCESSORIES : DESCRIBE NEW BT'S WITNESS OBJECTS ETC. ESTABLISHED, OR WORK DONE TO PRESERVE EXISTING EVIDENCE

ATTACHED 54-4 SIGNS ON SIDE OF TREES AWAY FROM CORNER,
PAINTED BLAZES & RED BANDS AROUND TREES

Work Done By B.A. Sutton Title SURVEYOR Date 11-19-84 State Registration No. PLS 1848
or Agency

Certified Cor. Record Prepared ? Yes No Filed At: _____ Date _____

REMARKS

Index File No. P-05 T. 1N R. 36E M. WILLIAMS Tract or Surv. No.

Cor. 1/4 13

19/20