

Index File No. 2-7

CORNER RECORD (SEARCH)

Tract or Survey No. _____

Cor. No. _____


T. 1N R. 36E

R.D. _____ County _____

Merid. _____

N.F. Unionville State Ore.

CORNER DIAGRAM

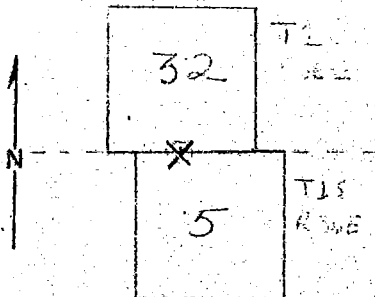

DESCRIBE CORNER MONUMENT FOUND

None found.

DESCRIBE BEARING TREES OR OTHER OFFICIAL ACCESSORIES FOUND

FIR BT (SNAG) 35" DBH BEARS APPROX. South 19 LKS.
APPROX. 20 ft West of bottom of draw.

PINE BT not found. Record: 8" FR S40°W, 34 LKS
6" FR N60°E, 11 LKS

PHOTO IDENTIFICATION DATA

Photo No. EGO(7/19/66) 2-299

Filed At: _____

Object Ident. FIR BT

Ident. By Ken Magowan
Signature

PLANE COORDINATE POSITION DATA

State _____ Zone _____

X _____

Y _____

Estab. By _____ Agency _____

DESCRIBE CORNER LOCATION RELATIVE TO NEAR-BY FEATURES, ALSO HOW TO REACH CORNER

Area of corner located by walking NW from Haron along railroad tracks. Cor. also accessible from top of Horse Heaven Ridge road.

Signature

Title

Division

Headquarters

Date

Ken Magowan Eng. Aide U.S. Forest Service; Unionville N.F. 16 Sept 1966 7100-52
REV. 65 5

CORNER RECORD (PERPETUATION)

MENT DESCRIBE NEW MONUMENT SET, OR WORK DONE TO PRESERVE EXISTING MONUMENT

ESSORIES : DESCRIBE NEW BT'S WITNESS OBJECTS ETC. ESTABLISHED, OR WORK DONE TO PRESERVE EXISTING EVIDENCE

Flagged (ORANGE) & painted (RED) BT.

Done By MARVIN BENSON Title Eng. Aide Date 9/2/69 State Registration No. USFS

Filed Cor. Record Prepared? Yes No Filed At: _____ Date _____

REMARKS

CORNER position computed by scaling on photo no. EQO (7/19/66)
7 from known section cor. 40 chains west.
PIN prick on photo is FIR BT.

File No. 7-57 T. 1 N. R. 31 M. 1111 (4) Tract or Survey No. _____