

Index

File No. Z-25

CORNER RECORD (SEARCH)

(Ref. FSM 7151.4)

Tract or

Survey No. _____

Cor.

No. _____

T 2N R. 36E

R.D. Walla Walla


County Umatilla

Merid. Willamette

N.F. Umatilla

State Oregon

CORNER DIAGRAM Sec.36

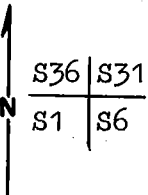

DESCRIBE CORNER MONUMENT FOUND

Basalt stone 21x16x10- 6 notches East & West & North & South.

DESCRIBE BEARING TREES OR OTHER OFFICIAL ACCESSORIES FOUND

Orig. 18" Fir now 24" shattered Wh. Fir stub-N32E-18 lks. partial scribing visible.
Orig. 20" Fir now 28" Wh. Fir snag 20 ft. tall S18E-23 lks. scribing visible on previously opened double blaze.

PHOTO IDENTIFICATION DATA

Photo No. 1280-49
Filed At. Umatilla N.F.
Object Ident. two I.P.'s
Ident. By L. D. [Signature]
Signature

DESCRIBE CORNER LOCATION RELATIVE TO NEAR-BY FEATURES, ALSO HOW TO REACH CORNER

From the signed wood post where the East line of Section 36 crosses Rd. #3128 go South 350 ft. to corner.

PLANE COORDINATE POSITION DATA

State _____ Zone _____
X _____
Y _____
Estab. By _____
Agency

Larry D. [Signature]

Title Land Surveyor Division _____ Headquarters _____

Date 6/83 7100-52-(3.68)

CORNER RECORD (PERPETUATION)

MONUMENT: DESCRIBE NEW MONUMENT SET, OR WORK DONE TO PRESERVE EXISTING MONUMENT

Set 2½" x 30" Aluminum pipe with a 3" Aluminum cap and a breakaway footplate containing a magnet in a mound of stone.

ACCESSORIES : DESCRIBE NEW BT'S WITNESS OBJECTS ETC. ESTABLISHED, OR WORK DONE TO PRESERVE EXISTING EVIDENCE

13" Spruce N71-3/4W-21.5 ft. scribed T2NR36ES36BT and with a 1" Brass disk stamped PLS 896.
11" Spruce S53W-15.0 ft. scribed T1NR36ES1BT and with a 1" Brass disk stamped PLS 896.
14" Spruce N49E-18.7 ft. scribed T2NR37ES31BT and with a 1" Brass disk stamped PLS 896.
8" Wh.Fir S81½E-10.2 ft. scribed T1NR37ES6BT and with a 1" Brass disk stamped PLS 896.

Work Done By Larry D. Bishop Title Surveyor Date 6/83 State Registration No. 896
or Agency

Certified Cor. Record Prepared ? Yes No Filed At: _____ Date _____

REMARKS


Set guard posts North & West with signs 54-2 and 54-4.
Nailed 54-4 and BT signs to BT's and painted band and blazes red.

Index File No. Z-25
T 2N R. 36E
Merid. WILL.

CORNER RECORD (SEARCH)
(Ref. FSM 7151.4)
R.D. WALLA WALLA County UMATILLA
N.F. UMATILLA State OREGON

Tract or Survey No. _____
Cor. No. _____

CORNER DIAGRAM

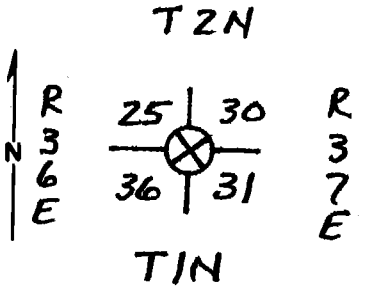

DESCRIBE CORNER MONUMENT FOUND

STONE SET SOLIDLY IN PLACE & MARKED WITH 6 NOTCHES ON ALL 4 CARDINAL EDGES.

DESCRIBE BEARING TREES OR OTHER OFFICIAL ACCESSORIES FOUND

A SHATTERED FIR STUMP w/ UPPER BLAZE PREVIOUSLY OPENED & SCRIBING VISIBLE & A HEALED LOWER BLAZE BEARS N 32° E, 11.9 FT.

A 25' HIGH FIR SNAG w/ UPPER BLAZE PREVIOUSLY OPENED & SCRIBING VISIBLE & A HEALED LOWER BLAZE BEARS S 18° E, 15.2 FT. OTHER TWO BT'S GONE.

DESCRIBE CORNER LOCATION RELATIVE TO NEAR-BY FEATURES, ALSO HOW TO REACH CORNER

200' SOUTH OF BLACK MT. Rd.

PHOTO IDENTIFICATION DATA

Photo No. _____
Filed At. _____
Object Ident. _____
Ident. By _____
Signature

PLANE COORDINATE POSITION DATA

State _____ Zone _____
X _____
Y _____
Estab. By _____
Agency

Signature Dennis L. Gaylord Title _____ Division PLS 1636 Headquarters _____ Date 7-2-82

CORNER RECORD (PERPETUATION)

MONUMENT : DESCRIBE NEW MONUMENT SET, OR WORK DONE TO PRESERVE EXISTING MONUMENT

ACCESSORIES : DESCRIBE NEW BT's WITNESS OBJECTS ETC. ESTABLISHED, OR WORK DONE TO PRESERVE EXISTING EVIDENCE

Work Done By _____ Title _____ Date _____ State Registration No. _____
or Agency _____

Certified Cor. Record Prepared ? Yes No Filed At: _____ Date _____

REMARKS

Index File No. T. R. M. Tract or Surv. No. Cor.