

USDA-FOREST SERVICE

Index _____

File No. C-1

CORNER RECORD (SEARCH)

(Ref. FSM 7151.4)

Tract or

Survey No. _____

Cor.

No. _____


T 1N R. 38E

R.D. Walla Walla County Union

Merid. Willamette

N.F. Umatilla State Oregon

CORNER DIAGRAM

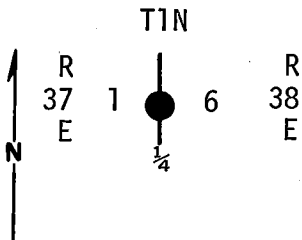

DESCRIBE CORNER MONUMENT FOUND

None

DESCRIBE BEARING TREES OR OTHER OFFICIAL ACCESSORIES FOUND

None

PHOTO IDENTIFICATION DATA

Photo No. F16616160 1577-122

Filed At. Umatilla Nat For

Object Ident. Direct

Ident. By G. Langlitz

Signature

DESCRIBE CORNER LOCATION RELATIVE TO NEAR-BY FEATURES, ALSO HOW TO REACH CORNER

Corner located approx. 100 ft. West of U.S.F.S. road.

PLANE COORDINATE POSITION DATA

State _____ Zone _____

X _____

Y _____

Estab. By _____

Signature
G. Langlitz
Agency

Title
Land Surveyor

Division
PLS 1099

Headquarters _____


Date
10-14-80

7100-52 (3. 68)

CORNER RECORD (PERPETUATION)

MONUMENT : DESCRIBE NEW MONUMENT SET, OR WORK DONE TO PRESERVE EXISTING MONUMENT

Corner set from survey by single proportionate measurement.
 At the corner point, we set a 2"x30" galvanized iron pipe,
 28" in the ground, with brass cap attached, marked:

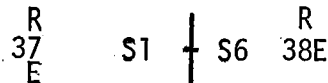

PLS 1099
1980

ACCESSORIES : DESCRIBE NEW BT'S WITNESS OBJECTS ETC. ESTABLISHED, OR WORK DONE TO PRESERVE EXISTING EVIDENCE

From which we mark new BT's:
 A 12" White Fir, scribed " $\frac{1}{4}$ " S1 BT" on a double blaze, bears N15⁰W 49.6 ft.,
 A 14" Larch, scribed " $\frac{1}{4}$ " S6 BT" on a double blaze, bears S66⁰E 46.0 ft.
 Attached brass washer, marked "LS 1099" to lower blaze of new BT's. Placed steel
 fencepost 5 ft. N of monument with sign 54-9 attached. Attached signs and painted BT's
 per Standard Specifications For Cadastral Survey, U.S.F.S. Region 6, October 1979.

Work Done By Gary Langlitz Title Land Surveyor Date 10-14-80 State Registration No. PLS 1099
 or Agency

Certified Cor. Record Prepared? Yes No Filed At: Union County Surveyor Date Dec. 1980

REMARKS

Compass Declination: 18⁰ East

Witness: John Curtiss

Index File No. C-1 T. 1N R. 38E M. Willamette Tract or Surv. No. Cor.

10
11
12