

USDA-FOREST SERVICE

Index File No. J-1

CORNER RECORD (SEARCH)

(Ref. FSM 7151.4)

Tract or Survey No.

Cor. No.

T 1N R. 38E

R.D. Walla Walla County

Union


Merid. Willamette

N.F. Umatilla

State

Oregon

CORNER DIAGRAM

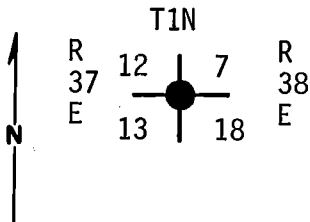

DESCRIBE CORNER MONUMENT FOUND

None.

DESCRIBE BEARING TREES OR OTHER OFFICIAL ACCESSORIES FOUND

We establish the True Corner Point in the following relationship to the original bearing trees as follows: An orig. 2½" Fir, now a 6" Dead Windfall Douglas Fir, with scribing "38E S7 B" visible on a partially healed single blaze bears N73°E 13.2 ft. An orig. 6" Fir, now a 10" White Fir, alive and in fair condition, with scribing "138S" visible on a partially healed upper blaze, lower blaze well-healed bears S80°E 11.9'.

DESCRIBE CORNER LOCATION RELATIVE TO NEARBY FEATURES, ALSO HOW TO REACH CORNER

An orig. 7" Fir, now a 16" White Fir, alive with well-healed double blaze, bears S68°W 5.9 ft., And an Orig. 7" Fir, now an 18" Grand Fir, alive with well-healed double blaze, bears N50°W 17.8 ft.

PHOTO IDENTIFICATION DATA

Photo No. _____
 Filed At. _____
 Object Ident. _____
 Ident. By _____

Signature

PLANE COORDINATE POSITION DATA

State _____ Zone _____
 X _____
 Y _____
 Estab. By _____

Agency

Signature
 Gary L. Langhitt

Title Division Headquarters
 Land Surveyor PLS 1099


Date
 9/30/80

7100-52 (3. 68)

CORNER RECORD (PERPETUATION)

MONUMENT: DESCRIBE NEW MONUMENT SET, OR WORK DONE TO PRESERVE EXISTING MONUMENT

At the True Corner Point, we set a 2"x30" Galvanized Iron Pipe, 28" in the ground on a steep NW slope, with brass cap attached, marked:

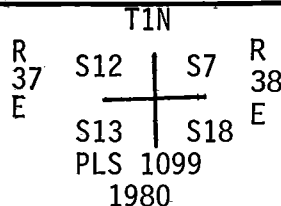

ACCESSORIES : DESCRIBE NEW BT's WITNESS OBJECTS ETC. ESTABLISHED, OR WORK DONE TO PRESERVE EXISTING EVIDENCE

From which we mark new BTs: A 6" White Fir, scribed "T1N R38E S7 BT" on a double blaze bears N49¹/₂°E 53.1 ft., and a 6" Spruce, scribed "T1N R38E S18 BT" on a double blaze bears S19⁰E 25.7 ft.

Attached brass washer, marked "LS 1099" to lower blaze of new BTs.

Placed steel fence post 5 ft. N of monument with sign 54-4 attached.

Attached signs and painted BTs per Standard Specifications for Cadastral Survey, U.S.F.S. Region 6, October, 1979.

Work Done By Gary Langlitz Title Land Surveyor Date 9/30/80 State Registration No. PLS 1099
or Agency

Certified Cor. Record Prepared? Yes No Filed At: Union County Surveyor Date Dec. 1980

REMARKS

Compass Declination: 20° East

Witness: John Curtiss