

CORNER RECORD (SEARCH)

(Ref. FSM 7151.4)

Index File No. U-1/a

Tract or Survey No. _____ Cor. No. _____


T 1N R. 37E.

R.D. Walla Walla County Umatilla

Merid. W.M.

N.F. Umatilla State OR

CORNER DIAGRAM

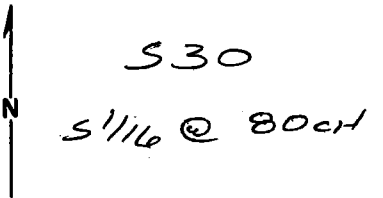

DESCRIBE CORNER MONUMENT FOUND

None

DESCRIBE BEARING TREES OR OTHER OFFICIAL ACCESSORIES FOUND

None

PHOTO IDENTIFICATION DATA

Photo No. _____
 Filed At. _____
 Object Ident. _____
 Ident. By _____
 Signature _____

DESCRIBE CORNER LOCATION RELATIVE TO NEAR-BY FEATURES, ALSO HOW TO REACH CORNER

EXTREMELY STEEP NORTH SLOPE.

PLANE COORDINATE POSITION DATA

State _____ Zone _____
 X _____
 Y _____
 Estab. By _____
 Agency _____

Signature Murkel P. Zegena
 Title P.L.S.

Division _____ Headquarters _____

Date 10/93

CORNER RECORD (PERPETUATION)

MONUMENT: DESCRIBE NEW MONUMENT SET, OR WORK DONE TO PRESERVE EXISTING MONUMENT

At a section subdivision as determined by this survey set a 3/4" aluminum cap on a 2 1/2" x 30" aluminum pipe, 24" in the ground

TINR 37E
S 1/4 80
530
PLS 2535
1993

ACCESSORIES: DESCRIBE NEW BT'S WITNESS OBJECTS ETC. ESTABLISHED, OR WORK DONE TO PRESERVE EXISTING EVIDENCE

11" Douglas Fir bears N. 41 1/2° W., 50.5 feet scribed S 1/16 80 S 30 BT.
1 1/2" aluminum cap (PLS 2535) on a 5/8" x 24" rebar bears N. 29 1/2° E., 9.2 ft.

Work Done By LeJeune Title P.L.S. Date 9/93 State Registration No. 2535
or Agency

Certified Cor. Record Prepared Yes No Filed At: _____ Date _____

REMARKS

Index File No.

4-1/2

T.
IN.

R.
37E.

M.
W.M.

Tract or Surv. No.

Cor.