

USDA-FOREST SERVICE

Index File No. V-3

CORNER RECORD (SEARCH)

(Ref. FSM 7151.4)

Tract or Survey No. _____

Cor. No. _____

T 1N R. 37E

R.D. Walla Walla


County Umatilla

Merid. W.M.

N.F. Umatilla

State Oregon

CORNER DIAGRAM

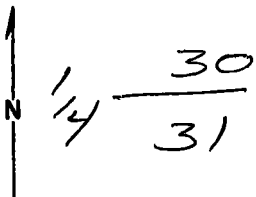

DESCRIBE CORNER MONUMENT FOUND

Original bearing tree at a record topo call distance from creek in the proper direction of the original fir in the SE quadrant, hardened face no visible scribing marks.

DESCRIBE BEARING TREES OR OTHER OFFICIAL ACCESSORIES FOUND

21" Douglas fir badly decayed w/ healed face No visible scribing marks.

PHOTO IDENTIFICATION DATA

Photo No. _____
 Filed At. _____
 Object Ident. _____
 Ident. By _____
 Signature _____

DESCRIBE CORNER LOCATION RELATIVE TO NEAR-BY FEATURES, ALSO HOW TO REACH CORNER

K TAG ON FOOT TRAIL 200' EAST TO CORNER ON OPEN HILLSIDE, NORTH OF A MINOR DRAW

PLANE COORDINATE POSITION DATA

State _____ Zone _____
 X _____
 Y _____
 Estab. By _____
 Agency _____

Signature

Title

Division

Headquarters

Date

FS-7100-52 (3/68)

Melvin P. Zeff P.L.S.

10/93

CORNER RECORD (PERPETUATION)

MONUMENT: DESCRIBE NEW MONUMENT SET, OR WORK DONE TO PRESERVE EXISTING MONUMENT

At a record bearing and distance pull from the original southeast bearing tree, Set a 3/4" USFS cap on a 2 1/2" x 30" aluminum pipe 25" in the ground.

TIN R37E
 530
 1/4 ———
 531
 PLS 2535
 1993

ACCESSORIES : DESCRIBE NEW BT'S WITNESS OBJECTS ETC. ESTABLISHED, OR WORK DONE TO PRESERVE EXISTING EVIDENCE

- 18" Ponderosa Pine, S. 82 1/2° W., 27.9 feet scribed 1/4S 31 BT
- 21" Ponderosa Pine, S. 45° E., 38.9 feet scribed 1/4S 31 BT.
- 1 1/2" aluminum cap (P.L.S. 2535) on a 5/8" x 24" rebar bears N. 19 1/2° E., 17.7 Ft.
- 1 1/2" aluminum cap (PLS 2535) on a 5/8" x 24" rebar bears N. 71° W., 18.4 Ft.

Work Done By LeJeune Title PLS Date 9/93 State Registration No. 2535
 or Agency

Certified Cor. Record Prepared ? Yes No Filed At: _____ Date _____

REMARKS

USDA-FOREST SERVICE

Index

File No. V-3

CORNER RECORD (SEARCH)

(Ref. FSM 7151.4)

Tract or Survey No. _____ Cor. No. _____


T IN R. 37E

R.D. WALLA WALLA County UMATILLA

Merid. WILLAMETTE

N.F. UMATILLA State OREGON

CORNER DIAGRAM

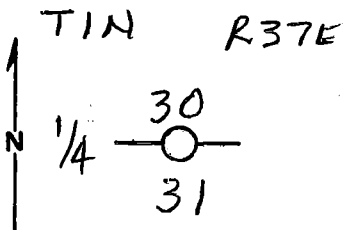

DESCRIBE CORNER MONUMENT FOUND

NONE

DESCRIBE BEARING TREES OR OTHER OFFICIAL ACCESSORIES FOUND 2

NONE

PHOTO IDENTIFICATION DATA 6

Photo No. _____

Filed At. _____

Object Ident. _____

Ident. By _____

Signature

PLANE COORDINATE POSITION DATA 7

State _____ Zone _____

X _____

Y _____

Estab. By _____

Agency

DESCRIBE CORNER LOCATION RELATIVE TO NEAR-BY FEATURES, ALSO HOW TO REACH CORNER 3

Signature

Title

Division

Headquarters

Date

FS-7100-52 (3/68)

Dennis T. Gaylord

PLS 1636

50

AUG 5, 1992

CORNER RECORD (PERPETUATION)

MONUMENT: DESCRIBE NEW MONUMENT SET, OR WORK DONE TO PRESERVE EXISTING MONUMENT

9

ACCESSORIES : DESCRIBE NEW BT'S WITNESS OBJECTS ETC. ESTABLISHED, OR WORK DONE TO PRESERVE EXISTING EVIDENCE

10

Work Done By _____ Title _____ Date _____ State Registration No.
or Agency _____

Certified Cor. Record Prepared ? Yes No Filed At: _____ Date _____ 11

REMARKS

12

Index File No. T. R. M. Tract or Surv. No. Cor. 13