


Index
File No. Z-21
T LN R. 37E
Merid. WILL

CORNER RECORD (SEARCH)

(Ref. FSM 7151.4)

Tract or Survey No. _____ Cor. No. _____
R.D. WALLA WALLA County UMATILLA
N.F. UMATILLA State OREGON

CORNER DIAGRAM

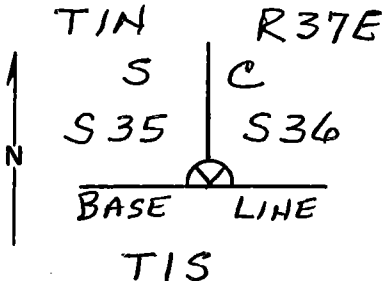

DESCRIBE CORNER MONUMENT FOUND

GONE (STEEP GROUND)

DESCRIBE BEARING TREES OR OTHER OFFICIAL ACCESSORIES FOUND

ORIGINAL 24" DOUG. FIR IS LIVE WITH DOUBLE HEALED BLAZES. BEARS N 45° W, 33.7 FT. THE OTHER 2 BT'S OF RECORD ARE GONE, PLACED BT SIGN ON BT & A LOCATION POSTER ON RIDGE TOP & TRAIL 1,200 FT EAST OF CORNER.

DESCRIBE CORNER LOCATION RELATIVE TO NEAR-BY FEATURES, ALSO HOW TO REACH CORNER

DRIVE TO END OF JEEP ROAD (# 3100-159) IN S36 THEN HIKE SOUTH ON TRAIL TO LOCATION POSTER (ABOUT 2,000 FT.)

PHOTO IDENTIFICATION DATA

Photo No. _____
Filed At. _____
Object Ident. _____
Ident. By _____
Signature

PLANE COORDINATE POSITION DATA

State _____ Zone _____
X _____
Y _____
Estab. By _____
Agency

Signature Dennis L. Hayford Title _____ Division PLS 1636 Headquarters S.O. Date 7-16-86
FS-7100-52 (3/68)

CORNER RECORD (PERPETUATION)

MONUMENT: DESCRIBE NEW MONUMENT SET, OR WORK DONE TO PRESERVE EXISTING MONUMENT

9

ACCESSORIES : DESCRIBE NEW BT'S WITNESS OBJECTS ETC. ESTABLISHED, OR WORK DONE TO PRESERVE EXISTING EVIDENCE

10

Work Done By _____ Title _____ Date _____ State Registration No. _____
or Agency _____

Certified Cor. Record Prepared ? Yes No Filed At: _____ Date _____

11

REMARKS

12

Index File No. T. R. M. Tract or Surv. No. Cor. 13