

USDA-FOREST SERVICE

Index
File No. V-25
T IN R. 37E
Merid. WILL.


CORNER RECORD (SEARCH)

(Ref. FSM 7151.4)

Tract or
Survey No. _____ Cor.
No. _____

R.D. WALLA WALLA County UMATILLA-UNION Co. LINE
N.F. UMATILLA State OREGON

CORNER DIAGRAM

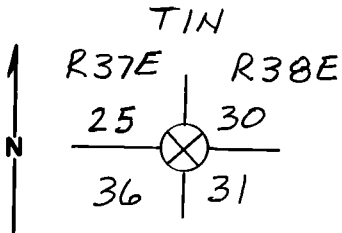

DESCRIBE CORNER MONUMENT FOUND

NONE

DESCRIBE BEARING TREES OR OTHER OFFICIAL ACCESSORIES FOUND

ORIG. 30" FIR IS A 36" W. FIR WITH NEARLY HEALED BLAZES. I OPEN SLIGHTLY & FIND SCRIBING & REVERSE. BEARS S82°E, 68.6 FT.

PHOTO IDENTIFICATION DATA

Photo No. _____
Filed At. _____
Object Ident. _____
Ident. By _____
Signature

ORIG. 30" FIR IS DOWN & DECAYED. I ROLL OVER & FIND A SCRIBED SEGMENT, "BT" BEARS N 56°E, 85.8 FT.

DESCRIBE CORNER LOCATION RELATIVE TO NEAR-BY FEATURES, ALSO HOW TO REACH CORNER

ORIGINAL 20" FIR LINE TREE IS A 24" DOUG. FIR WITH A 3.5 FT x 1 FT. HEAD HIGH BLAZE ON NORTH SIDE. BLAZE HAS PARTLY HEALED. BEARS N 30°E, 638 FT FROM CORNER & IS VISIBLE FROM CORNER. THIS CORNER IS 150' EAST OF RIDGE TOP, & 250 FT SE OF SUMMIT ROAD IN SADDLE.

PLANE COORDINATE POSITION DATA

State _____ Zone _____
X _____
Y _____
Estab. By _____
Agency

Signature

Title

Division

Headquarters

Date

7100-52-(3,68)

Dennis L. Laylord

PLS 1636

9/28/81

4

5

CORNER RECORD (PERPETUATION)

MONUMENT : DESCRIBE NEW MONUMENT SET, OR WORK DONE TO PRESERVE EXISTING MONUMENT

ACCESSORIES : DESCRIBE NEW BT'S WITNESS OBJECTS ETC. ESTABLISHED, OR WORK DONE TO PRESERVE EXISTING EVIDENCE

Work Done By _____ Title _____ Date _____ State Registration No. _____
or Agency _____
Certified Cor. Record Prepared ? Yes No Filed At: _____ Date _____

REMARKS

Index File No. T. R. M. Tract or Surv. No. Cor.

Index File No. V-25 (V-1)


CORNER RECORD (SEARCH)
(Ref. FSM 7151.4)

Tract or Survey No. _____ Cor. No. _____

T IN R. 37E (38E) R.D. WALLA-WALLA County UMATILLA-UNION Co. LINE

Merid. Willamette N.F. UMATILLA State OCEGON

CORNER DIAGRAM

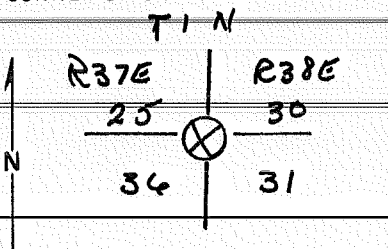

DESCRIBE CORNER MONUMENT FOUND

None

DESCRIBE BEARING TREES OR OTHER OFFICIAL ACCESSORIES FOUND

Orig. 30" fir is a 36" w. fir w/ nearly healed blazes. I opened slightly & find scribing & reverse. Brs. S82°E, 68.6 ft.
Orig. 30" fir is down & decayed. I roll over & find ascribed segment, BT" Brs. N156°E, 85.8 ft
Orig. 20" fir line tree is a 24" D f w/ a 3.5ft. x 1ft head high blaze on N. side. Blaze has partly healed. Brs ~~N~~ N3°E, 638ft from corner and is visible from corner.

DESCRIBE CORNER LOCATION RELATIVE TO NEAR-BY FEATURES, ALSO HOW TO REACH CORNER

This corner is 150' east of ridge-top, & 250ft SE of Summit Rd. 31, in saddle.

PHOTO IDENTIFICATION DATA

Photo No. _____
 Filed At. _____
 Object Ident. _____
 Ident. By _____
 Signature _____

PLANE COORDINATE POSITION DATA

State _____ Zone _____
 X _____
 Y _____
 Estab. By _____
 Agency _____

Signature
Dennis Gaylord

Title
PLS 1636

Division
UMATILLANE

Headquarters
9/28/81

Date
7100-52-(3-68)