

OREGON CORNER RESTORATION FORM

Section 4 Township 1S Range 31E
 County Umatilla Date: October 4, 2001

Corner Designation: 1S31A11

North 1/4 section corner to section 4, T1S, R31E,
 W.M., Umatilla County, Oregon.


Condition Report Only
 Not found
 Remonumented
 Unrecorded
 Surveyed in
 Referenced out

Previous Renewals / Surveys, etc.

The corner was originally set by David P. Thompson under contract No. 106 dated August 16, 1864. His record reads: Set post for 1/4 sec. closing corner in mound of earth with charred stake, pits, trench and C. as per instructions. In survey H-7-B, Donald Staebler, Engineer 5408, records Found pit and charred stake for 1/4 sec. closing corner as per notes. Set brass cap.."

Monument and Accessories found: (condition and source)

The brass cap set by Staebler had been knocked over by road maintenance activities. I found no evidence of the charred stake buried at the position of Staebler's monument.

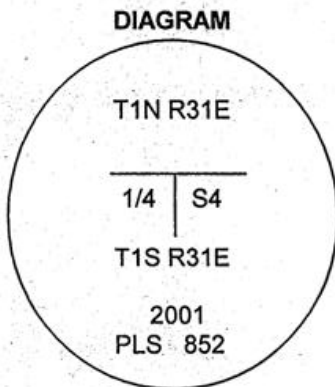

MONUMENT (S) AND ACCESSORIES SET (Procedures and Description)

At the point calculated from Staebler's monuments to the south I set a 30" x 1 1/2" G.I.P. with a 2 1/2" brass cap stamped as shown in the diagram above flush with the surface. I set a 5' steel guard post with a County Monument sign attached along side.

For references, I set four 5/8" by 24" rebars with 1 1/4" red plastic caps stamped ORLS 852, and WAL5 13922 as described below:

- an iron rebar bears N44°45'11"E, 12.38 feet, in the existing fence;
- an iron rebar bears N82°36'07"W, 54.87 feet, in the existing fence;
- an iron rebar bears S40°09'11"W, 82.91 feet in the existing fence;
- an iron rebar bears S57°38'04"E, 93.86 feet in the existing fence;

The monument and references were tied using a LIECA SYSTEM 300 RTK GPS.

Location and comments
 OR SPC Oregon North 1983-91
 N = 677921.13
 E = 8600469.10

Compass Declination


Surveyors Seal

RECEIVED BY:
Umatilla County Surveyor
 Date: 12/30/2001
 Rec'd By: WHK
 No. 01-206-C

Firm / Agency
 Haddock Surveying
 Address
 P.O. Box 1574
 Pendleton, Or. 97801
 Party Chief
 Stephen K, Haddock



David L. Haddock

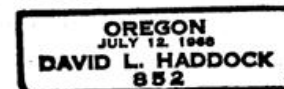

RENEWS 6-30-03