

OREGON CORNER RESTORATION FORM

Section 3 Township 2S Range 31E
 County Umatilla Date: April 8, 2011

Corner Designation: 2S31A13

Corner to sections 33 and 34, T1S, R31E, and sections 3 and 4, T2S, R31E, W.M., Umatilla County, Oregon.



Previous Renewals / Surveys, etc.

Corner originally set by David P. Thompson under contract No. 106 dated August 16, 1864. His record reads: Set post for corner to Secs 3, 4, 33 & 34 in mound of earth with a charred stake, pits, trench, & c. as per instructions.

Condition Report Only
 Not found
 Remonumented
 Unrecorded
 Surveyed in
 Referenced out

Monument and Accessories found: (condition and source)

An intersection of fences with fences running East, West and South. The area has been plowed.

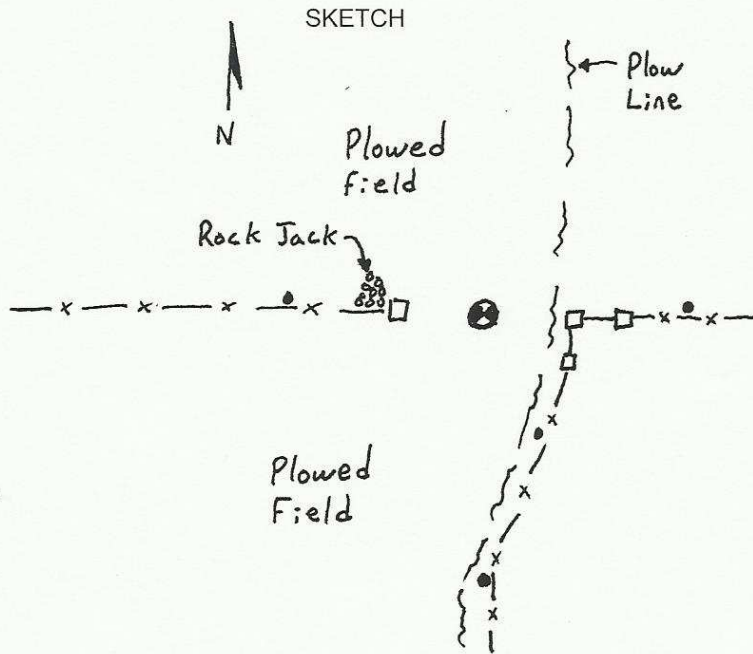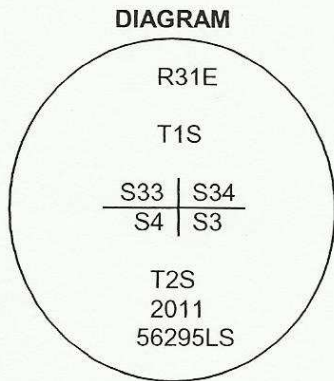

⊗ = Brass Cap
 ● = Rebar Reference

MONUMENT (S) AND ACCESSORIES SET (Procedures and Description)

At the corner point determined by the fences I set a 2 3/8" brass cap on a 1 1/2"x30" galvanized iron pipe 36" in the ground.

For references, I set four, 5/8" by 24" rebars with 1.25" orange plastic caps stamped WTS and 56295LS as described below:

- an iron rebar bears S1°06'27"E, 185.34 feet at the angle point in the fence to the south;
- an iron rebar bears S21°25'38"E, 33.88 feet under the existing fence;
- an iron rebar bears N89°40'35"E, 33.20 feet under the existing fence;
- an iron rebar bears N87°58'29"W, 55.35 feet under the existing fence;

The monument and references were tied using a Trimble R7/R8 RTK GPS system.

Location and comments

Compass Declination

Surveyors Seal

RECEIVED BY:
 Umatilla County Surveyor
 Date: _____
 Rec'd By: _____
 No. 11-112-C

Firm / Agency
 Witness Tree Surveying
 Address
 P.O. Box G
 Pilot Rock, Or. 97868
 Party Chief
 Stephen K, Haddock

REGISTERED
 PROFESSIONAL
 LAND SURVEYOR

Stephen K. Haddock

OREGON
 JULY 9, 2001
 STEPHEN K. HADDOCK
 56295LS

RENEWAL DATE 6-30-13