


CERTIFIED RECORD OF LAND CORNER MONUMENTATION

Corner to Sections 1 and 2, T1S, R32E, W. M.

Index: 1S 32 A-21

DIAGRAM

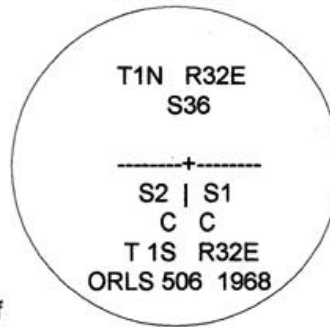

History of original corner establishment:
 Corner originally set by Thompson in contract 106 dated 1864.
 His record reads: 80.00 Set post for corner to secs. 1 and 2
 from which A balm 6 ins. diam. bears N.86°E., 11 lks. dist.
 A balm 5 ins. diam. bears S.55°E., 54 lks. dist.
 A balm 6 ins. diam. bears S.20°W. 50 lks. dist.

In 1889, under special instructions, Currin re-established this
 corner as a closing corner. His record reads: N. on a random
 bet. Secs. 1 & 2. 79.90 Intersect Base Line 17.37 chs. W. of
 Cor. to Secs. 36 & 36 of T. 1 N., R. 32 E. I could find no trace of
 old Closing Cor. and set basalt stone, 12x 9x 7 ins., 8 ins. in ground
 for Closing Cor. to Secs. 1 & 2, marked 1 notch on E. 5 on W. edges, C. C. on S. face.

Ralph Thompson, ORLS 506, personally showed me this corner and said he had set the brass
 cap at the position of Currin's record stone.

Evidence Found: Found Ralph Thompson's brass cap in a mound of stone in good condition
 and stamped as shown in the diagram, 0.5 feet south of an east - west fence.

Description of monument and accessories I established to perpetuate the
 original location of this corner:
 I set two 5/8" by 24" rebars with 1.25" red plastic caps stamped ORLS 852 and WALSL 13922 as
 described below:
 a rebar bears S87°27'E, 54.50 feet under the east bound fence;
 a rebar bears S89°39'W, 55.31 feet under the west bound fence;
 Found a 3/4" rebar on the northeast side of Shaw Road which bears S79°38'W, 246.49 feet
 from the corner. Found a 5/8" rebar, with yellow plastic cap stamped LS 2627, on the east side
 of Shaw Road which bears S59°30'W, 231.65 feet from the corner.

The bearings are true.

This work was done June 10, 1997, and witnessed by Stephen K. Haddock.

County of Umatilla

Office of _____, I hereby certify that the within instrument was filed
 State of _____

in this office for record on the _____ day of _____ by _____

(DEPUTY)

(COUNTY OFFICIAL)



David L. Haddock



RECEIVED BY
 Umatilla County Surveyors
 Date 7-97
 Rec'd By KK
 No. 97-140-C