


CERTIFIED RECORD OF LAND CORNER MONUMENTATION

North quarter corner to Section 6, T1S, R32E, W M.

Index: 1S 32 A-3

History of original corner establishment:
Corner originally set by Thompson in contract 106 dated 1864. His record reads: 39.60 Set a stone 15x10x6 ins., for 1/4 sec. closing corner.

Evidence Found: None

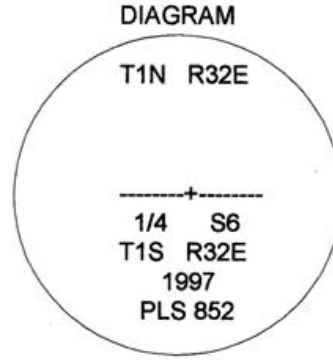

Description of monument and accessories I established to perpetuate the original location of this corner:

At the point proportioned between the corner of T1N and R31 and 32E, and the found stone, set by survey recorded in book 2, page 299, for the corner to Sections 32 and 33, T1N, R32E,

I set a 1.25" x 12" galvanized iron pipe with a 2.25" brass cap, stamped as shown in the diagram, 24" below the surface in a wheat field about 170 feet east of a fence corner. The monument is cemented into a hole chiseled into rock.

I set four 5/8" by 24" rebars with 1.25" red plastic caps stamped ORLS 852 and WALS 13922 as described below:

- a rebar bears N89°16'46"W, 216.22 feet under a west bound fence;
- a rebar bears N70°41'28"W, 178.14 feet under a north bound fence;
- a rebar bears N56°59'45"W, 200.49 feet under a north bound fence;
- a rebar bears N89°02'18"W, 168.66 feet under a west bound fence at a fence corner;

The bearings are true.

This work was done June 17, 1997, and witnessed by Stephen K. Haddock.

County of Umatilla

Office of _____, I hereby certify that the within instrument was filed
State of _____
in this office for record on the _____ day of _____ by _____
_____(COUNTY OFFICIAL) (DEPUTY)

RECEIVED BY

Umatilla County Surveyor
Date: 7-97
Rec'd By: KR
No. 97-140-C

**REGISTERED
PROFESSIONAL
LAND SURVEYOR**

David L. Haddock

**OREGON
JULY 16, 1906
DAVID L. HADDOCK
852**