


CERTIFIED RECORD OF LAND CORNER MONUMENTATION

North quarter corner to Section 5, T1S, R32E, W M.

Index: 1S 32 A-7

History of original corner establishment:  
Corner originally set by Thompson in contract 106 dated 1864. His record reads: 40.00 Set stone 15x10x6 ins., for 1/4 sec. closing corner.

Evidence Found: None

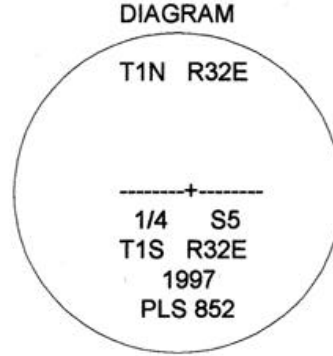

Description of monument and accessories I established to perpetuate the original location of this corner:

At the point proportioned between the corner of T1N, R31E and 32E, and the found stone, set by survey recorded in Record of Surveys, book 2, page 299, for the corner to Sections 32 and 33, T1N, R32E,

I set a 1.25" x 6" galvanized iron pipe with a 2.25" brass cap, stamped as shown in the diagram, flush with the surface in a small fenced area near a ranch house. The monument is cemented into a hole chiseled into rock. A sealed well casing bears N22°16'W, 6.40 feet marked with a punch mark, an arrow and the letters BO.

I set three 5/8" by 24" rebars with 1.25" red plastic caps stamped ORLS 852 and WAL5 13922 as described below:

- a rebar bears N2°48'E, 38.61 feet under an east - west fence;
- a rebar bears S74°42'W, 90.88 feet at the base of a power pole;
- a rebar bears S76°42'E, 112.11 feet; at the base of a power pole

The bearings are true.

This work was done June 16, 1997, and witnessed by Stephen K. Haddock.

Office of \_\_\_\_\_, I hereby certify that the within instrument was filed  
 State of \_\_\_\_\_  
 in this office for record on the \_\_\_\_\_ day of \_\_\_\_\_ by \_\_\_\_\_  
 \_\_\_\_\_ ( COUNTY OFFICIAL ) ( DEPUTY )

REGISTERED  
PROFESSIONAL  
LAND SURVEYOR

*David L. Haddock*

OREGON  
JULY 12, 1988  
DAVID L. HADDOCK  
852

RECEIVED BY  
Umatilla County Surveyor  
Date 7-97  
Rec'd By KK  
No. 97-140-C