

OREGON CORNER REFORMATION FORM

Section 15 Township 1S Range 32E
 County Umatilla Date: May 12, 2007

Corner Designation: 1S32N15

Condition Report Only
 Not found
 Remonumented
 Unrecorded
 Surveyed in
 Referenced out

Quarter corner common to sections 15 and 22, T1S, R32E, W.M., Umatilla County, Oregon.


Previous Renewals / Surveys, etc.

Corner originally set by Daniel Chaplin under contract No. 107 dated September 21, 1864. His record reads: Set post for 1/4 Sec. Cor., in mound of earth, with charred stake, pits, etc., as per instructions.


Monument and Accessories found: (condition and source)

A long term possessory fence intersection with fences running West, North, and East.

DIAGRAM

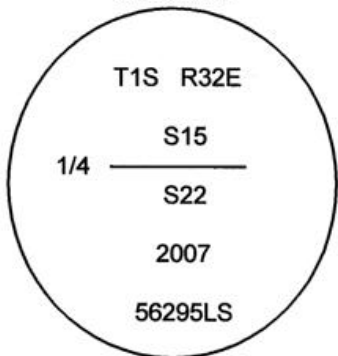

SKETCH

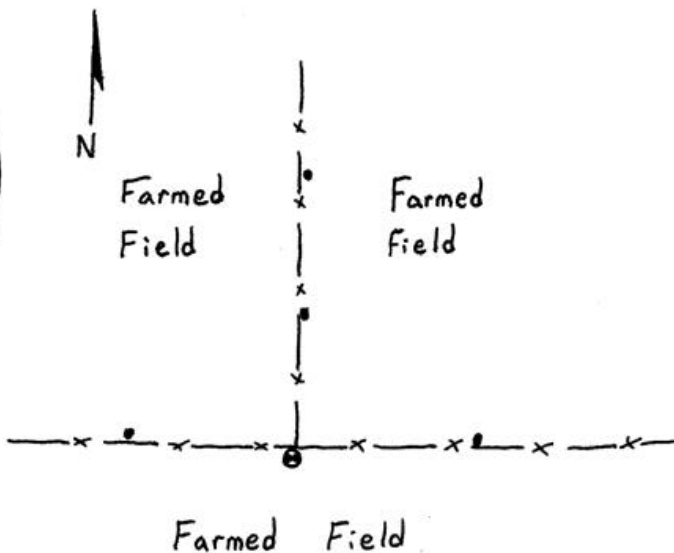

⊙ = Brass Cap
 ● = Rebar Reference

MONUMENT (S) AND ACCESSORIES SET (Procedures and Description)

At the fence corner, I set a 1 1/2" x 30" galvanized iron pipe with a 2 1/4" brass cap attached stamped as shown in the diagram above.

For references, I set four 5/8" by 24" rebars with 1.25" orange plastic caps stamped WTS and 56295LS under the existing fences as described below:

- an iron rebar bears S89°58'14"E, 36.33 feet;
- an iron rebar bears N0°53'50"E, 34.59 feet;
- an iron rebar bears N0°01'37"E, 86.39 feet;
- an iron rebar bears N89°43'05"W, 40.32 feet;

The monument and references were tied using a Trimble R7/R8 RTK GPS.

Location and comments

Compass Declination

Surveyors Seal

RECEIVED BY:
Umatilla County Surveyor
 Date: 7-07
 Rec'd By: KF
 No. 07-192-B

Firm / Agency
 Witness Tree Surveying
 Address
 P.O. Box G
 Pilot Rock, Or. 97868
 Party Chief
 Stephen K, Haddock

REGISTERED
 PROFESSIONAL
 LAND SURVEYOR

Stephen K. Haddock

OREGON
 JULY 9, 2001
 STEPHEN K. HADDOCK
 56295LS

RENEWAL DATE 6-30-09