

OREGON CORNER RECORATION FORM

Section 19 Township 1S Range 32E
 County Umatilla Date: March 24th, 2006

Corner Designation: 1S32N3

Quarter corner common to sections 18 and 19, T1S, R32E, W.M., Umatilla County, Oregon.



Condition Report Only
 Not found
 Remonumented
 Unrecorded
 Surveyed in
 Referenced out

Previous Renewals / Surveys, etc.

Corner originally set by Daniel Chaplin under contract No. 107 dated Sept 21, 1864.
 His record reads: Set stone 20x12x10 for 1/4 Sec. Cor. This corner was found by Don Staebler in 1974 in survey I-22-B. His record reads: Found stone Mkd. 1/4.

Monument and Accessories found: (condition and source)

I found a basalt stone 17x10x7 marked 1/4 tipped to the north. An "x" had been chisled into the stone near the "1" of the 1/4 at the top of the stone.

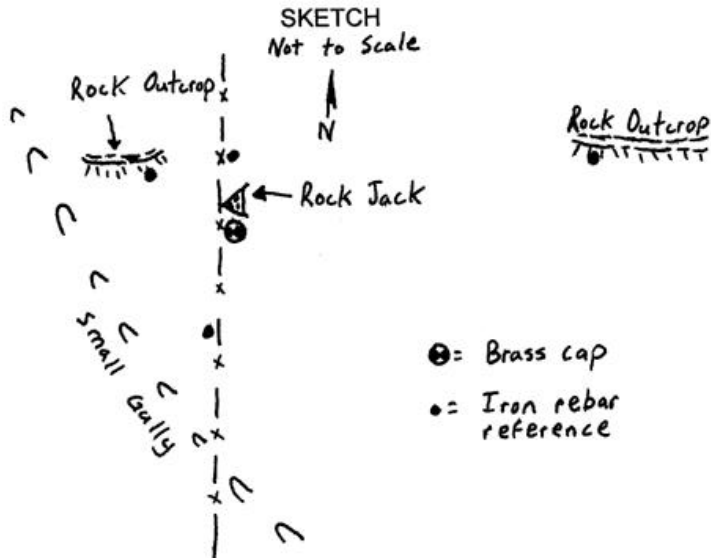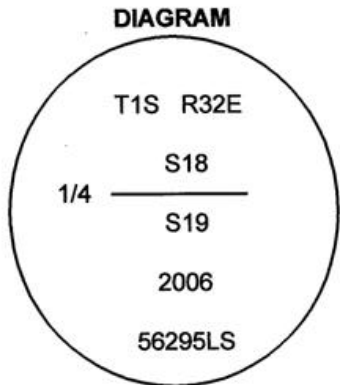

MONUMENT (S) AND ACCESSORIES SET (Procedures and Description)

At the position of the stone I drilled a 4" hole in the bedrock and cemented a 5/8" x 8" iron rebar into the hole. I then cemented a 1 1/4" x 6" galvanized iron pipe with a 2 1/4" brass cap to the rebar. I set the stone face down on the south side of the cap and raised dirt around both to the top of the cap. The stone is only partially buried as there was little soil here.

For references, I set four 5/8" by 24" rebars with 1.25" orange plastic caps stamped WTS and 56295LS as described below:

- an iron rebar bears N64°01'12"W, 54.03 feet in a small rock outcrop;
- an iron rebar bears N2°30'19"E, 44.03 feet;
- an iron rebar bears N61°44'28"E, 178.79 feet in a small rock outcrop;
- an iron rebar bears S2°33'56"W, 106.97 feet;

The monument and references were tied using a Trimble R7/R8 RTK GPS.

Location and comments
 Corner work witnessed by
 Mr. Terry Hamby

Compass Declination

Surveyors Seal

RECEIVED BY:
Umatilla County Surveyor
 Date: 4-06
 Rec'd By: [Signature]
 No. 06-056-13

Firm / Agency
 Witness Tree Surveying
 Address
 P.O. Box G
 Pilot Rock, Or. 97868
 Party Chief
 Stephen K, Haddock

REGISTERED
 PROFESSIONAL
 LAND SURVEYOR

Stephen K. Haddock

OREGON
 JULY 9, 2001
 STEPHEN K. HADDOCK
 56295LS

RENEWAL DATE 6-30-07