

**OREGON CORNER RELOCATION FORM**

Section 19 Township 1S Range 32E  
 County Umatilla Date: March 29th, 2006



Corner Designation: 1S32N5 Condition Report Only  
 Not found  
 Corner to sections 17, 18, 19 and 20, T1S, R32E W.M. x Remonumented  
 Unrecorded  
 Surveyed in  
x Referenced out

**Previous Renewals / Surveys, etc.**

Corner originally set by Daniel Chaplin under contract No. 107 dated September 21, 1864.  
 His record reads: Set post for corner to sections 17, 18, 19, & 20 in mound of earth with charred stake, pits &c. as per. Don Staebler proportioned this corner under survey I-22-B in 1974. His record states: Set 1" x 36" iron pin.

**Monument and Accessories found: ( condition and source )**

I found the iron pin by Staebler. It was set in the wrong location as Don did not use the correct corners to the east or south for his proportioning. There is also an error of 6.35 feet in his measured distance to the section corner to the east.

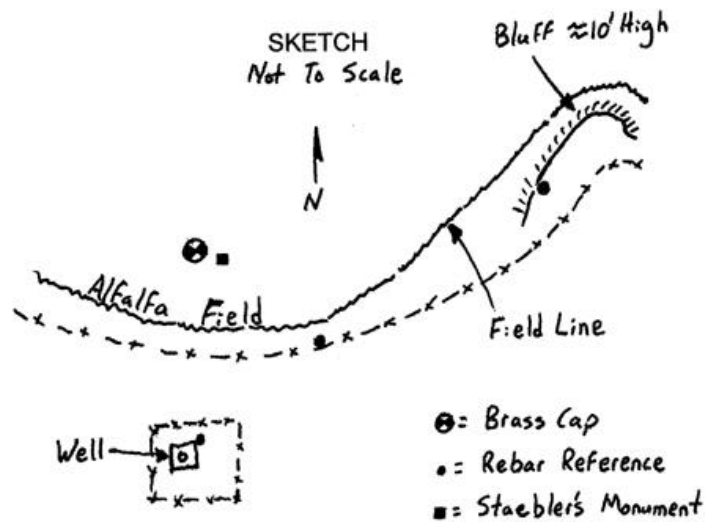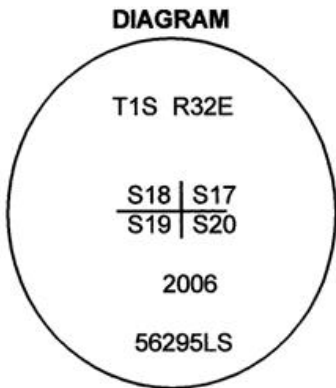

**MONUMENT (S) AND ACCESSORIES SET (Procedures and Description)**

At the proportionate point I set a 1 1/4" x 30" Galvanized Iron Pipe with a 2 1/2" brass cap stamped as shown in the diagram above 2 feet below the surface in a farm field.  
 For references I set three 5/8" x 24" iron rebars with 1.25" orange plastic caps stamped WTS and 56295LS as described below:  
 an iron rebar bears S3°44'36"W, 297.76 feet at the NE corner of a 4'x4' concrete slab at a well;  
 an iron rebar bears S64°22'00"E, 277.68 feet 1 foot north of a railroad tie fence post.  
 an iron rebar bears N68°01'52"E, 640.33 feet at the top of a small bluff;  
 a 5/8" iron pin by Staebler bears S74°33'15"E, 10.78', 2 feet below the surface.

The monument and references were tied using a Trimble R7/R8 RTK GPS

Location and comments  
 Corner work witnessed by  
 Mr. Terry Hamby.

Compass Declination  
 Firm / Agency  
 Witness Tree Surveying  
 Address  
 P.O. Box G  
 Pilot Rock, OR 97868  
 Party Chief  
 Stephen K, Haddock

Surveyors Seal

RECEIVED BY:  
Umatilla County Surveyor  
 Date: 4-06  
 Rec'd By: [Signature]  
 No. 06-056-B

REGISTERED  
 PROFESSIONAL  
 LAND SURVEYOR

*Stephen K. Haddock*

OREGON  
 JULY 9, 2001  
 STEPHEN K. HADDOCK  
 56295LS

RENEWAL DATE 6-30-07