

OREGON CORNER REFORMATION FORM

Section 17 Township 1S Range 32E
 County Umatilla Date: Sept 2, 2003

Corner Designation: 1S32N7


Condition Report Only
 Not found
 Remonumented
 Unrecorded
 Surveyed in
 Referenced out

Quarter corner common to sections 17 and 20, T1S, R32E, W.M., Umatilla County, Oregon.


Previous Renewals / Surveys, etc.

Corner originally set by Daniel Chaplin under contract No. 107 dated Sept 21, 1864. His record reads: Set post for 1/4 Sec. Cor., in mound of earth, with charred stake, pits, etc., as per instructions. ODOT survey 1R-2-971 shows a tie to this corner in 1940 but does not identify the monument.

Monument and Accessories found: (condition and source)
 None

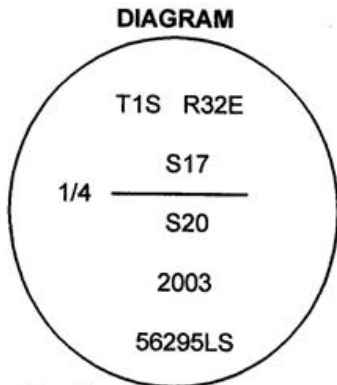

- ⊙ = Brass cap
- = Rebar reference
- = Guard Post

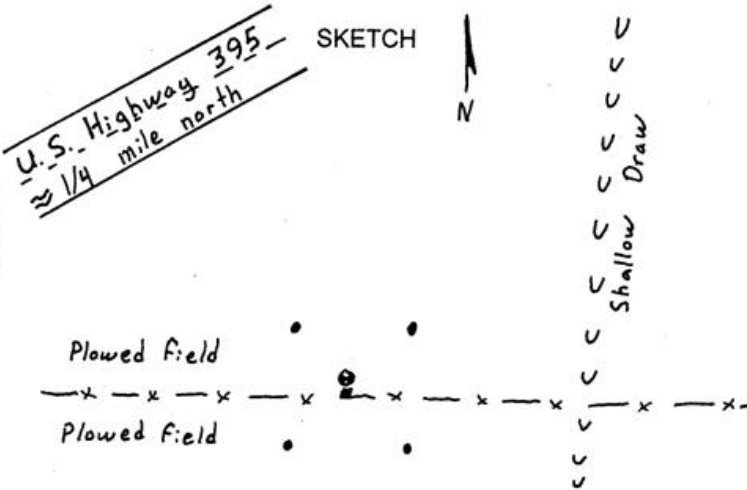

MONUMENT (S) AND ACCESSORIES SET (Procedures and Description)

I replaced this monument based on the survey of the ODOT property which is now the property of the Pilot Rock school district. The survey was performed for the ODOT scale & maintenance site in 1940. The location agrees well with the legal descriptions in the area. The monument set is a brass cap buried 20" below the surface and about 3ft north of the fence.

For references, I set four 5/8" by 24" rebars with 1.25" orange plastic caps stamped WTS and 56295LS as described below:

- an iron rebar bears N46°11'44"W, 23.53 feet;
- an iron rebar bears N47°50'05"E, 23.34 feet
- an iron rebar bears S42°03'17"E, 24.37 feet;
- an iron rebar bears S39°20'01"W, 23.74 feet;

The monument and references were tied using a LIECA system 300 RTK GPS.

Location and comments

NAD 83-91 coordinates from GPS
 ties to Tri Stations Birch and Alkali.
 N 662478.58'

E 8627102.44'

Witnessed by Matt Jensen

RECEIVED BY:

Umatilla County Surveyor

Date: 3-04

Rec'd By: KK

No. 04-70-B

Compass Declination

Firm / Agency

Haddock Surveying

Address

P.O. Box 1574

Pendleton, Or. 97801

Party Chief

Stephen K, Haddock

Surveyors Seal

REGISTERED
 PROFESSIONAL
 LAND SURVEYOR

Stephen K. Haddock

OREGON
 JULY 9, 2001
 STEPHEN K. HADDOCK
 56295LS

RENEWAL DATE 6-30-06