

**OREGON CORNER RESTORATION FORM**

Section 23 Township 1S Range 32E  
County Umatilla Date: February 15, 2019

Corner Designation: 1S32P19


Center 1/4 corner to Section 23, T1S, R32E W.M.  
Umatilla County, Oregon.

|                       |          |
|-----------------------|----------|
| Condition Report Only |          |
| Not found             |          |
| Remonumented          | <u>x</u> |
| Unrecorded            |          |
| Surveyed in           |          |
| Referenced out        | <u>x</u> |


Previous Renewals / Surveys, etc.

This corner was originally established by Umatilla County Surveyor John Kimbrell in survey No. 110 found in the Record of Private Surveys Book 1, Page 409. Survey dated June 15, 1899. Kimbrell's record reads: Set stone 18x6x5 for 1/16th in center of section 23.

Monument and Accessories found: ( condition and source )  
A small mound of stone at a fence corner rock jack with fences running south and west.

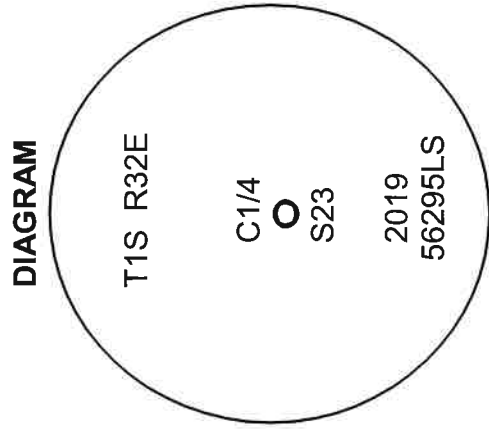

SKETCH

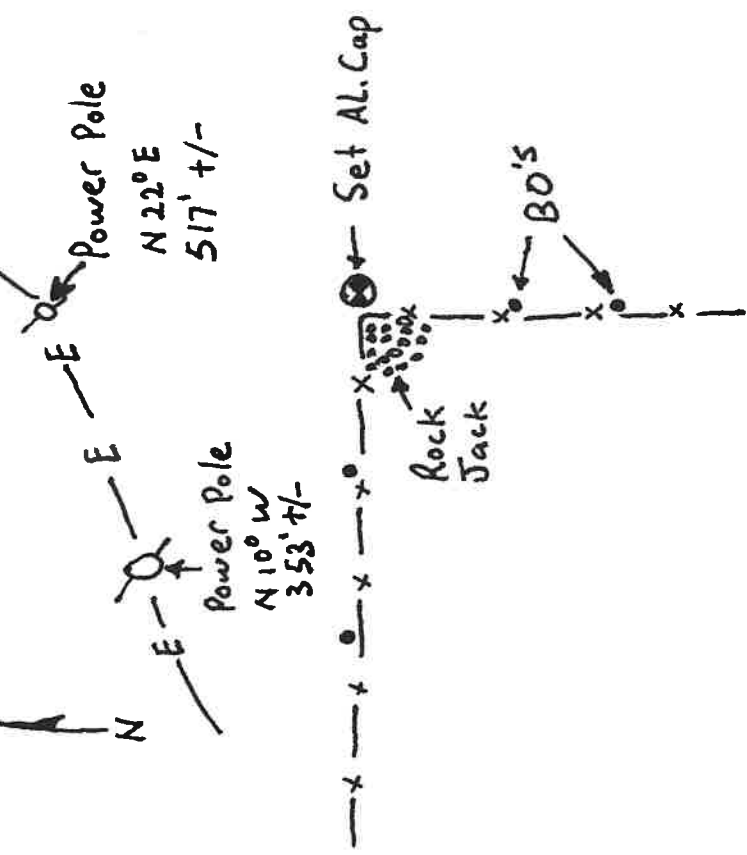

**MONUMENT (S) AND ACCESSORIES SET (Procedures and Description)**

I set a 1" x 24" iron rebar with a 2" aluminum Cap stamped as shown above flush with the surface of the ground at the fence corner. Raised a small mound over the monument.

For references, I set four 5/8" by 24" iron rebars with 1 1/8" orange plastic caps stamped WTS and 56295LS as described below:  
a rebar bears N88°00'08"W, 51.26 feet under the existing fence;  
a rebar bears N88°22'05"W, 25.11 feet under the existing fence;  
a rebar bears S00°41'20"W, 23.52 feet under the existing fence;  
a rebar bears S00°04'49"W, 49.05 feet under the existing fence;

The monument and references were tied using a Trimble R7/R8 RTK GPS.

Location and comments

Compass Declination

Surveyors Seal

RECEIVED BY:  
Umatilla County Surveyor  
Date: 3/5/19  
Rec'd By: CT  
No. 19-022-8

Firm / Agency  
Witness Tree Surveying  
Address  
P.O. Box G  
Pilot Rock, Or. 97868  
Party Chief  
Stephen K, Haddock

REGISTERED  
PROFESSIONAL  
LAND SURVEYOR

*Stephen K. Haddock*

OREGON  
JULY 9, 2001  
STEPHEN K. HADDOCK  
56295LS

RENEWS: 6-30-19