



OREGON CORNER REFORMATION FORM

Section 3 Township 1S Range 34E
 County Umatilla Date: July 29, 1997

Corner Designation: 1S34J15 Condition Report Only
 Not found
 Quarter corner to sections 10 and 15, T1S, R34E W.M. Remonumented
 Unrecorded
 Surveyed in
 Referenced out

Previous Renewals / Surveys, etc.
 Corner originally set by Currin and Nolan under special contract dated May 4, 1887.
 His record reads: Set basalt stone, 20x16x12 15 ins. in ground, for 1/4 Sec. Cor., marked 1/4 on N. face. Raised mound of stone around it. Pits impracticable.

Monument and Accessories found: (condition and source)
 Found record size stone, with apparent unreadable scribe chisel marks, in stone mound at intersection of north-south and east fences. Fences have only scattered remains and wire rolls remaining.

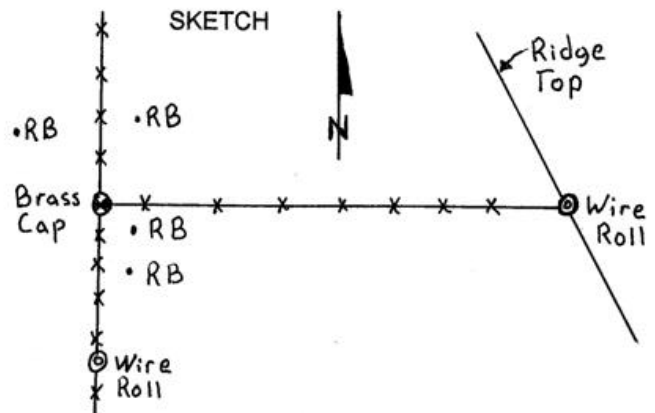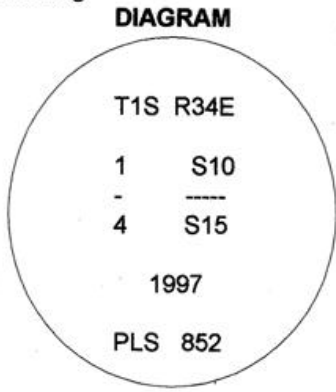

MONUMENT (S) AND ACCESSORIES SET (Procedures and Description)
 Set a 1 1/4" x 30" Galvanized Iron Pipe with a 2 1/2" brass cap stamped as shown in the diagram above at the position of the stone. The cap is 12" above the surface of the ground with a large mound of stone and a steel fence post nearby with Land Survey Monument sign.

For references, I set four 5/8" by 24" rebars with 1.25" red plastic caps stamped ORLS 852 and WAL5 13922 as described below:

- a rebar bears S29°20'E, 19.16 feet in a stone mound;
- a rebar bears S64°37'E, 11.38 feet in a stone mound.
- a rebar bears N43°00'W, 30.04 feet in a stone mound;
- a rebar bears N23°08'E, 23.92 feet in a stone mound.

Monument and reference locations were surveyed with GPS receivers.
 The bearings and distances are true

Location and comments

Compass Declination

Surveyors Seal

RECEIVED BY:
Umatilla County Surveyor
 Date: 9-97
 Rec'd By: KK
 No. 97-173-B

Firm / Agency
 Haddock Surveying
 Address
 P.O. Box 1574
 Pendleton, Or. 97801
 Party Chief
 David L. Haddock
 Witness

