


**OREGON CORNER RESTORATION FORM**

Section 8 Township 1S Range 35E  
 County Umatilla Date: December 28, 1999

Corner Designation: 1S35G5  
 Condition Report Only  
 Not found  
 Quarter corner to sections 7 and 8, T1S, R35E W.M.  Remonumented  
 Unrecorded  
 Surveyed in  
 Referenced out

Previous Renewals / Surveys, etc.  
 Corner originally set by Currin and Nolan under special contract dated May 4, 1887.  
 His record reads: Set post, 36 x 3 x 3 ins., 2 ft. in ground, for 1/4 Sec. Cor. marked 1/4 S. on W. face, from which, a fir, 16 ins. diam., brs. N. 30°E., 55 lks. dist., marked 1/4 S., B. T.; a fir, 24 ins. diam., brs. S.60°W., 80 lks. dist., marked 1/4 S., B. T.

Monument and Accessories found: ( condition and source )  
 Found small stone mound with charred remnants of post in ground, from which a 48" fir stump bears S60°W, 52.8 feet; and a 24" fir stump bears N30°E, 36.3'.

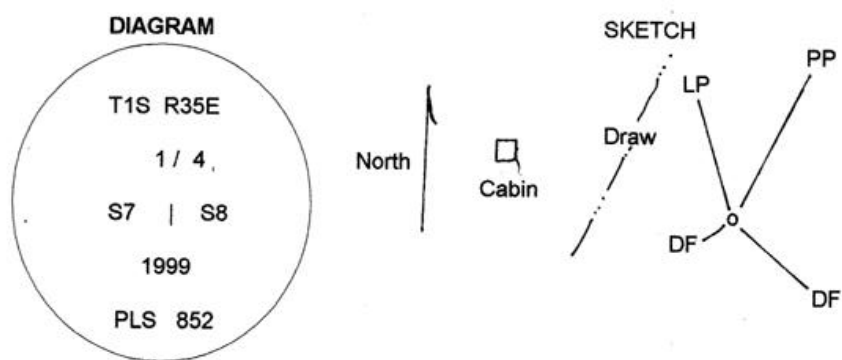

MONUMENT (S) AND ACCESSORIES SET (Procedures and Description)  
 Set a 1 1/4" x 30" Galvanized Iron Pipe with a 2 1/2" brass cap stamped as shown in the diagram above at the position of the rotten post. The cap is 12" above the surface of the ground in a small mound of stone.

For references, I scribed the following witness trees: A 14" Ponderosa Pine bears N21 1/2°E, 104.4' scribed 1/4 S8 BT; A 7" Douglas Fir bears S28°E, 58.8' scribed 1/4 S8 BT; A 12" Douglas Fir bears S68°W, 8.5' scribed 1/4 S7 BT; A 7" Lodgepole Pine bears N35 1/4°W, 44.8'. Each witness tree has a 3/4" aluminum tag stamped RLS 852 tacked between the scribed letters B and T.

Monument and reference locations were surveyed with a staff compass and cloth tape.

Location and comments

Compass Declination 20°

Surveyors Seal

RECEIVED BY:  
 Umatilla County Surveyor  
 Date: 12/30/99  
 Rec'd By: Dave K...  
 No. 99-314-B

Firm / Agency  
 Haddock Surveying  
 Address  
 P.O. Box 1574  
 Pendleton, Or. 97801  
 Party Chief  
 David L. Haddock  
 Witness

REGISTERED PROFESSIONAL LAND SURVEYOR  
*David L. Haddock*  
 OREGON JULY 12, 1968  
 DAVID L. HADDOCK  
 852