

OREGON CORNER RESTORATION FORM

Section 8 Township 1S Range 35E
 County Umatilla Date: December 28, 1999

Corner Designation: 1S35J7

Quarter corner to sections 8 and 17, T1S, R35E W.M.

Condition Report Only
 Not found
 Remonumented
 Unrecorded
 Surveyed in
 Referenced out


Previous Renewals / Surveys, etc.

Corner originally set by Currin and Nolan under special contract dated May 4, 1887.
 His record reads: Set post, 3 ft. long, 3 ins. sq., 24 ins. in ground, for 1/4 Sec. Cor., marked 1/4 S on N face, from which, A pine, 4 ins. diam., brs. N.15° E., 20 lks. dist., marked 1/4 S., B.T.; A tamarack, 18 ins. diam. brs. N.45°W., 45 lks. dist. marked 1/4 S. B.T.


Monument and Accessories found: (condition and source)

Found a Ponderosa Pine stump with only the pitch portion of the stump in the ground. The square remains of a pitch healing ring was laying alongside the tree. The area had been heavily logged and there were no other pine trees or stumps within 300'. There were no remains of an 18" or larger tamarack found in the area.

DIAGRAM

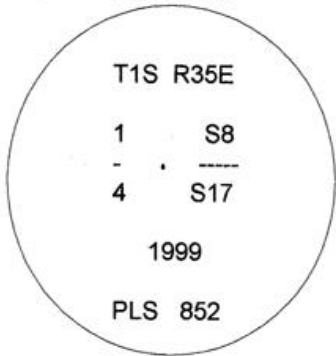

SKETCH

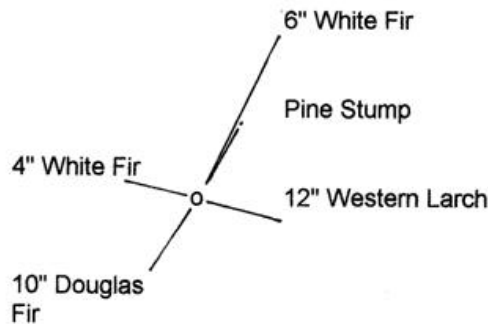

MONUMENT (S) AND ACCESSORIES SET (Procedures and Description)

Set a 1 1/4" x 30" Galvanized Iron Pipe with a 2 1/2" brass cap stamped as shown in the diagram above S15°W, 13.2' from the pitch stump. The cap is 6" above the surface of the ground with a collar of stone.

For references, I scribed the following witness trees: A 6" White Fir bears N14°E, 70.9' scribed 1/4 S8 BT; A 12" Western Larch bears S73°E, 74.0' scribed 1/4 S17 BT; A 10" Douglas Fir bears S38°W, 82.8' scribed 1/4 S17 BT; a 4" White Fir bears N56°W, 15.5'. Each witness tree has a 3/4 diameter aluminum tag stamped RLS 852 tacked between the letters B and T.

Monument and reference locations were surveyed with satff compass and cloth tape.

Location and comments

Compass Declination 20°

Surveyors Seal

RECEIVED BY:
Umatilla County Surveyor
 Date: 12/30/99
 Rec'd By: David Haddock
 No. 99-314-B

Firm / Agency
 Haddock Surveying
 Address
 P.O. Box 1574
 Pendleton, Or. 97801
 Party Chief
 David L. Haddock
 Witness

