

CERTIFIED RECORD OF LAND CORNER MONUMENTATION

**HISTORY OF ORIGINAL CORNER ESTABLISHED:**

Not previously established.

T 1 S R 35 E U-11

|  |    |  |
|--|----|--|
|  |    |  |
|  | S  |  |
|  | 28 |  |
|  |    |  |

**DESCRIPTION OF CORNER EVIDENCE FOUND:**

None.

**DESCRIPTION OF MONUMENT AND ACCESSORIES I ESTABLISHED TO MONUMENT THE**

**ORIGINAL LOCATION OF THIS CORNER:**

At position by survey I set a 5/8" x 30" iron pin, 27" in the ground, with 2 1/2" aluminum cap marked as shown below, from which:

**NEW BEARING OBJECTS:**


An 11" Ponderosa Pine bears North 56° East a dist. of 11.70 ft., marked CS 1/16 S28 BT.  
A 6" Douglas Fir bears South 13° West a dist. of 47.00 ft., marked CS 1/16 S28 BT.

I hereby certify that the corner was monumented on July 30, 2019.  
Witness: Kyle A. Tucker

Falls approx. 200' uphill of South Flowing draw on West aspect.



Renewal Date: June 30, 2021

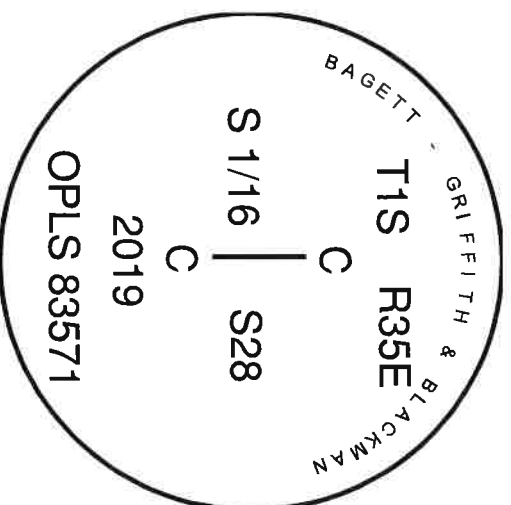

I used a steel tape and magnetic compass in the establishment of the new accessories. I used 13° East declination, the distances are to a 60d spike driven into the right side of the root crown of the bearing trees. A brass washer marked OPLS 83571 is attached to the BT blaze of the new bearing trees.

U-11

19-079-8