

USDA-FOREST SERVICE

Index
File No. U-21

CORNER RECORD (SEARCH)

(Ref. FSM 7151.4)

Tract or Survey No. _____ Cor. No. _____


T 1S R. 35E

R.D. WALLA WALLA County UMATILLA

Merid. WILLAMETTE

N.F. UMATILLA State OREGON

CORNER DIAGRAM

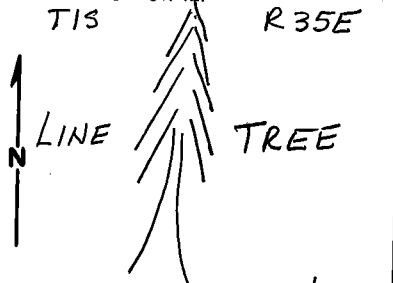

DESCRIBE CORNER MONUMENT FOUND

LINE TREE - 21.68 CHAINS NORTH OF $\frac{26}{35} / \frac{25}{36}$ IS A LARGE FIR IN GOOD CONDITION. HAS 2 ^{HEALED} NOTCHES ON SOUTH SIDE (INTO THE WOOD) AND 2 NOTCHES IN THE BARK ON THE NORTH SIDE & A HEALED BLAZE (INTO THE WOOD) 2

DESCRIBE BEARING TREES OR OTHER OFFICIAL ACCESSORIES FOUND

NONE - THE TOPOG. OF RECORD FITS EXTREMELY WELL & THE LINE TREE IS AT RECORD DISTANCE FROM SECTION CORNER. I PLACED 54-4 SIGNS, MARKED "LINE TREE", ON N & S SIDES & A "K" TAG AT BASE OF TREE ON EAST SIDE, ALSO MARKED "LINE TREE", 3

DESCRIBE CORNER LOCATION RELATIVE TO NEAR-BY FEATURES, ALSO HOW TO REACH CORNER

PHOTO IDENTIFICATION DATA

Photo No. _____
Filed At. _____
Object Ident. _____
Ident. By _____

Signature _____ 7

PLANE COORDINATE POSITION DATA

State _____ Zone _____
X _____
Y _____
Estab. By _____
Agency _____ 8

Signature Dennis L. Gaylord Title PLS 1636 Division _____ Headquarters _____ Date 6/24/81 4
7100-52-(3/68) 5

CORNER RECORD (PERPETUATION)

MONUMENT: DESCRIBE NEW MONUMENT SET, OR WORK DONE TO PRESERVE EXISTING MONUMENT

ACCESSORIES : DESCRIBE NEW BT'S WITNESS OBJECTS ETC. ESTABLISHED, OR WORK DONE TO PRESERVE EXISTING EVIDENCE

Work Done By _____ Title _____ Date _____ State Registration No. _____
or Agency _____

Certified Cor. Record Prepared ? Yes No Filed At: _____ Date _____

REMARKS

Index File No. T. R. M. Tract or Surv. No. Cor.