

**CERTIFIED RECORD OF LAND CORNER MONUMENTATION**

**HISTORY OF ORIGINAL CORNER ESTABLISHED:**

Corner originally established under GLO contract number 451 executed by Rufus S. Moore dated June 12th, 1882. Surveyor General field notes state: Set a post 4 ft. long, 4 ins. sq., 24 ins. in ground for cor. to secs. 26, 27, 34, + 35, 400 ft. above last dry gulch, marked T1SR35ES26 on NE, T1SR35ES27 on NW, S34 on SW and S35 on SE face with 1 notch on S and 2 notches on E edges, from which:


A Fir 36 ins. in dia. bears N45°E 15 lks. dist. marked T1SR35ES26BT.

A Fir 20 ins. in dia. bears N69°W 17 lks. dist. marked T1SR35ES27BT.

A Fir 12 ins. in dia. bears S55°W 42 lks. dist. marked T1SR35ES34BT.

A Fir 20 ins. in dia. bears S65°E 5 lks. dist. marked T1SR35ES35BT.

T 1 S R 35 E V-17

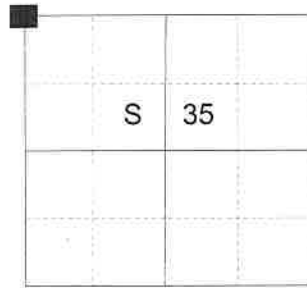

In 1975 Chris Palmer, as part of Survey M-46-C, notes: "Found Bearing Trees" and shows a monument on his map of survey.

**DESCRIPTION OF CORNER EVIDENCE FOUND:**

Found 5/8" iron pin, 3" above ground, with yellow plastic cap marked "PLS 872", from which:

A stump hole bears North 45° East, a distance of 9.90 feet.

A 26" diam. Fir stob bears North 69° West, a distance of 11.20 feet, dead and standing approx. 15 feet tall with "S24" scribes visible on opened blaze.

A 30" diam. Fir bears South 55° West, a distance of 27.70 feet, dead and down with partial scribes visible on opened blaze.

An approx. 22" diam. Fir bears South 65° East, a distance of 3.00 feet, dead, down, highly degraded, and rotted with Pilot Rock Lumber tag dated 1956 and no scribes visible.

An orange carsonite post bears approx. 2 feet South

**DESCRIPTION OF MONUMENT AND ACCESSORIES I ESTABLISHED TO PERPETUATE THE ORIGINAL LOCATION OF THIS CORNER:**

From the iron pin,

**NEW BEARING OBJECTS:**

A 7" diam. Western Larch bears North 37° East, a distance of 18.25 feet, marked T1SR35ES26 BT.

A 16" diam. White Fir bears South 71° East, a distance of 14.70 feet, marked T1SR35ES35 BT.

A 7" diam. Lodgepole Pine bears South 29° West, a distance of 26.45 feet, marked T1SR35ES34 BT.

A 7" diam. Lodgepole Pine bears North 36° West, a distance of 21.80 feet, marked T1SR35ES27 BT.

I hereby certify that the corner was monumented on September 9th, 2024.

Witness: Kyle Tucker



I use a tape and compass with 14° East declination in the establishment of the new bearing trees. Bearings are measured to a brass washer labeled OPLS 83571 nailed to the BT blaze of the base of the tree. Distances are measured to a 60D spike in the right side of the center of the base of the tree.

Renewal Date: June 30, 2025