

CERTIFIED RECORD OF LAND CORNER MONUMENTATION

HISTORY OF ORIGINAL CORNER ESTABLISHED:

Not previously established.

T 1 S R 35 E W-12

	S		
		33	

DESCRIPTION OF CORNER EVIDENCE FOUND:

None.

DESCRIPTION OF MONUMENT AND ACCESSORIES I ESTABLISHED TO MONUMENT THE

LOCATION OF THIS CORNER:

At position determined by survey I set a 5/8" x 20" iron pin 18" in the ground to bedrock, with 2 1/4" aluminum cap marked as shown below, from which:

NEW BEARING OBJECTS:

A 16" Ponderosa Pine bears South 45° West a dist. of 7.55 ft., marked NE1/16 S33 BT.


A 13" Ponderosa Pine bears North 47° West a dist. of 37.75 ft., marked NE1/16 S33 BT.

Set steel fence post approx. 1 ft. North


Falls on top edge of plateau approx. 40 ft. East of edge of steep West aspect.

I hereby certify that the corner was monumented on July 23, 2019.

Witness: Kyle A. Tucker

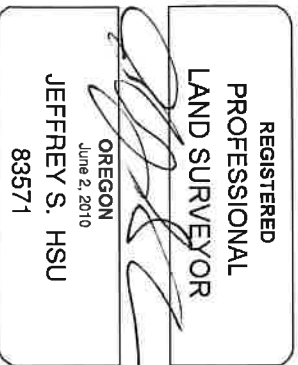

Renewal Date: June 30, 2021

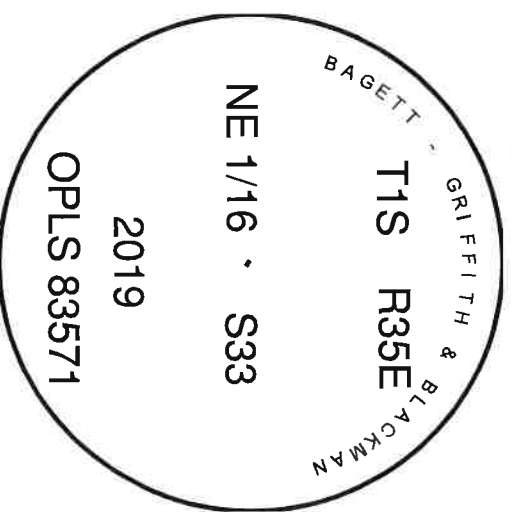

I used a steel tape and magnetic compass in the establishment of the new accessories. I used 13° East declination, the distances are to a 60d spike driven into the side of the root crown of the bearing trees. A brass washer marked OPLS 83571 is attached to the BT blaze of the new bearing trees.