


CEP IFIED RECORD OF LAND CORNER MONUMENTAT' Y

HISTORY OF ORIGINAL CORNER ESTABLISHMENT:

Corner not previously established

T 1 S R 35 E W-23

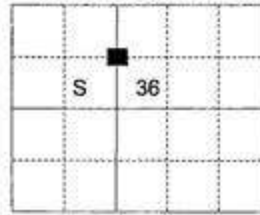

DESCRIPTION OF CORNER EVIDENCE FOUND:

A 2" carsonite post in a 1 ft. diam mound of stone bears South 70° West, a distance of 20.20 feet, with a 1" diam. iron pipe, 32" long, lying alongside.

See Survey Number 015-2011

DESCRIPTION OF MONUMENT AND ACCESSORIES I ESTABLISHED TO PERPETUATE THE ORIGINAL LOCATION OF THIS CORNER:

At the position determined by survey, I set a 5/8" x 30" iron pin with 2 1/2" aluminum cap marked as shown below, 29" in the ground from which:

BEARING OBJECTS:

A 13 inch Ponderosa Pine bears North 38° East, a distance of 76.88 feet, marked CN 1/16 S36 BT.


A 10 inch Ponderosa Pine bears North 15° West, a distance of 84.75 feet, marked CN 1/16 S36 BT.

I hereby certify that the corner was monumented on May 19, 2011.

Witness: Gregory T. Blackman Jr.



Renewal Date: June 30, 2011

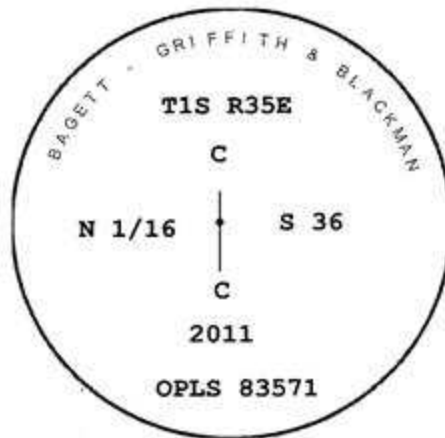

I used a magnetic compass and steel tape in the establishment of the accessories. Magnetic declination used was 16° East. The distances are to a 60d spike in the right hand side of the trees and bearings are to a brass washer marked OPLS 83571 in the upper portion of the BT blaze.