


CERTIFIED RECORD OF LAND CORNER MONUMENTATION

HISTORY OF ORIGINAL CORNER ESTABLISHED:

Corner originally established under GLO contract number 451 executed by Rufus S. Moore dated June 12th, 1882. Surveyor General field notes state: Set a post 3 ft. long, 3 ins. sq., 24 ins. in ground for 1/4 sec. cor., 200 ft. above last sec. cor. marked 1/4 S on W. face from which:
A Spruce 8 ins. in dia. bears N54°E 67 lks. dist. marked 1/4 S BT.
A Spruce 10 ins. in dia. bears S22°W 12 lks. dist. marked 1/4 S BT.

T 1 S R 35 E X-17

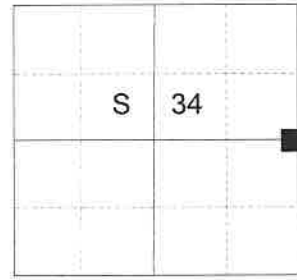

DESCRIPTION OF CORNER EVIDENCE FOUND:

None. Position falls in an area that has been historically heavily logged and most stumps have been ripped up and moved around.

DESCRIPTION OF MONUMENT AND ACCESSORIES I ESTABLISHED TO MONUMENT THE ORIGINAL LOCATION OF THIS CORNER:


At proportionate position, I set a 2 1/2" aluminum pipe, 28" in the ground, with 3" aluminum cap marked as shown below, from which:

NEW BEARING OBJECTS:

- An 8" diam. Spruce bears North 21° East, a distance of 34.15 feet, marked 1/4 S35 BT.
- A 10" diam. Lodgepole Pine bears South 38° East, a distance of 9.00 feet, marked 1/4 S35 BT.
- A 6" diam. White Fir bears South 14° West, a distance of 7.50 feet, marked 1/4 S34 BT.
- A 12" diam. Douglas Fir bears North 36° West, a distance of 15.80 feet, marked 1/4 S34 BT.

Set steel fence post approx. 0.5 feet North

I hereby certify that the corner was monumented on November 4th, 2024.

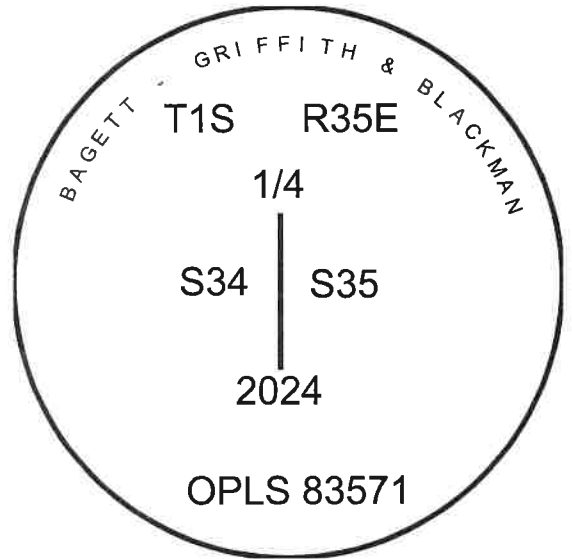

REGISTERED
PROFESSIONAL
LAND SURVEYOR



OREGON
June 2, 2010
JEFFREY S. HSU
83571

Renewal Date: June 30, 2025

I use a tape and compass with 14° East declination in the establishment of the new bearing trees. Bearings are measured to a brass washer labeled OPLS 83571 nailed to the BT blaze of the base of the tree. Distances are measured to a 60D spike in the right side of the center of the base of the tree.