

Index C - 13  
File No.

CORNER RECORD (SEARCH)

Tract or Survey No.

Cor. No. C - 13


T 1 S R. 36E

R.D. Pendleton County Umatilla

Merid. Willamette

N.F. Umatilla State Oregon

CORNER DIAGRAM T 1 N  
R 36 E

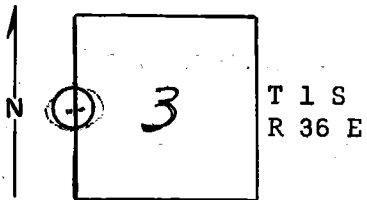

DESCRIBE CORNER MONUMENT FOUND

None found.

DESCRIBE BEARING TREES OR OTHER OFFICIAL ACCESSORIES FOUND

None found.

PHOTO IDENTIFICATION DATA

Photo No. EQ0(9/19/69)25-15

Filed At.

Object Ident.

Ident. By

Signature

DESCRIBE CORNER LOCATION RELATIVE TO NEAR-BY FEATURES, ALSO HOW TO REACH CORNER

Search area was a few chains south of Horseshoe Ridge Road.

PLANE COORDINATE POSITION DATA

State \_\_\_\_\_ Zone \_\_\_\_\_

X \_\_\_\_\_

Y \_\_\_\_\_

Estab. By \_\_\_\_\_

Agency



Signature

Title

Division

Headquarters

Date

7100-52

Gen Magaon

Eng. Aide

USFS Umatilla

N.P. SO

9-15-69

REV. 65 5

CORNER RECORD (PERPETUATION)

MONUMENT. DESCRIBE NEW MONUMENT SET, OR WORK DONE TO PRESERVE EXISTING MONUMENT

9

ACCESSORIES : DESCRIBE NEW BT'S WITNESS OBJECTS ETC. ESTABLISHED, OR WORK DONE TO PRESERVE EXISTING EVIDENCE

10

Work Done By \_\_\_\_\_ Title \_\_\_\_\_ Date 8/27/69 State Registration No. \_\_\_\_\_ or Agency \_\_\_\_\_

Certified Cor. Record Prepared ? Yes No Filed At: \_\_\_\_\_ Date \_\_\_\_\_

11

REMARKS

Orig. survey notes (1882) state that only a corner stone and rock mound were set for corner. Used aerial photo number EQO 25-15(9/9/67) and USGS Duncan Quadrangle map (1964). Searched about 45 minutes.

12

Index File No. C-13 T. 15 R. 36E M. Will: Tract or Surv. No. \_\_\_\_\_ Cor. C-13 <sup>13</sup>