

Index
File No. C-23

CORNER RECORD (SEARCH)

(Ref. FSM 7151.4)

Tract or
Survey No. _____ Cor.
No. _____


T 1S R. 36E

R.D. WALLA WALLA County UMATILLA

Merid. WILLAMETTE

N.F. UMATILLA State OREGON

CORNER DIAGRAM

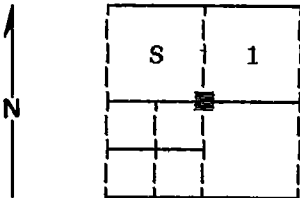

DESCRIBE CORNER MONUMENT FOUND

Corner not previously established.

DESCRIBE BEARING TREES OR OTHER OFFICIAL ACCESSORIES FOUND

Corner not previously established.

PHOTO IDENTIFICATION DATA

Photo No. _____

Filed At. _____

Object Ident. _____

Ident. By _____

Signature

PLANE COORDINATE POSITION DATA

State _____ Zone _____

X _____

Y _____

Estab. By _____

Agency

Signature

DESCRIBE CORNER LOCATION RELATIVE TO NEAR-BY FEATURES, ALSO HOW TO REACH CORNER

Corner falls on timbered West slope approximately 600 feet Northwest of the end of the 031 road.

Title
Surveyor

Division

Headquarters

Date
9-19-89

FS-7100-52 (3/68)

[Handwritten signature]

CORNER RECORD (PERPETUATION)

MONUMENT: DESCRIBE NEW MONUMENT SET, OR WORK DONE TO PRESERVE EXISTING MONUMENT

Set a 2½"x30" aluminum pipe with aluminum cap marked as shown:
Pipe is set 24 inches in the ground.

T1S R36E
C ¼

Raised a mound of stone around monument, 3 ft. base to top of cap.

S 1
1989
OPLS 644

ACCESSORIES : DESCRIBE NEW BT¹/₂ WITNESS OBJECTS ETC. ESTABLISHED, OR WORK DONE TO PRESERVE EXISTING EVIDENCE

New BTs:

A 13 inch diameter White Fir bears S82°E, 37.23 feet marked C¼ S1 BT

A 14 inch diameter Western Larch bears S1°W, 12.16 feet marked C¼ S1 BT

Painted a 6 inch red band around all bearing trees and attached 54-3 and 54-9 signs.

Set a steel fence post approximately 5 feet East with 54-2 and 54-9 signs attached.

Work Done By D.I. Griffith Title Surveyor Date 9-10-89 State Registration No. OPLS 644
or Agency

Certified Cor. Record Prepared? Yes No Filed At: Umatilla Co. Surveyor's Office Date 9-89

REMARKS

Index File No. Q-23 T. 1S

R. 36E W.M.

Tract or Surv. No.

Cor.