

Index
File No. E-10

CORNER RECORD (SEARCH)

(Ref. FSM 7151.4)

Tract or
Survey No. _____
Cor. No. _____

T 15 R. 36E


R.D. _____ County UMATILLA

Merid. WILL.

N.F. UMATILLA State OR

CORNER DIAGRAM

DESCRIBE CORNER MONUMENT FOUND

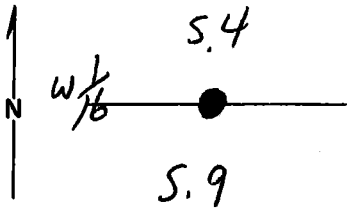

2 1/2" GALV. IRON PIPE WITH BLM BRASS CAP,
IN LARGE STONE MOUND, MKD. ->
MOUND IS IN POOR CONDITION

W 1/16 54
59
1984

DESCRIBE BEARING TREES OR OTHER OFFICIAL ACCESSORIES FOUND

20" PINE, SCRIBED "W 1/16 S9 BT", BEARS S 28 1/2° E, 264 1/2 LKS.
24" PINE, SCRIBED "W 1/16 54 BT" BEARS N 22° E, 548 1/2 LKS.

PHOTO IDENTIFICATION DATA

Photo No. _____
Filed At. _____
Object Ident. _____
Ident. By _____

Signature

DESCRIBE CORNER LOCATION RELATIVE TO NEAR-BY FEATURES, ALSO HOW TO REACH CORNER

LIES ON OPEN, ROCKY E. SLOPE ABOUT 100' E.
OF RIDGE TOP.

PLANE COORDINATE POSITION DATA

State _____ Zone _____
X _____
Y _____
Estab. By _____

Agency

Signature

Victor McInd Title LS

Division

Headquarters

Date

8-19-85

FS-7100-52 (3/68)

CORNER RECORD (PERPETUATION)

MONUMENT: DESCRIBE NEW MONUMENT SET, OR WORK DONE TO PRESERVE EXISTING MONUMENT

ACCESSORIES : DESCRIBE NEW BT'S WITNESS OBJECTS ETC. ESTABLISHED, OR WORK DONE TO PRESERVE EXISTING EVIDENCE

ATTACHED SIGN 54-4 TO BACK OF BT'S
PAINTED RED BAND AROUND BT'S.
SET STEEL POST ABOUT 3 FT. FROM CORNER WITH SIGN 54-9
REBUILT STONE MOUND AROUND CORNER

Work Done By. V. McLIND Title LS Date 6-3-86 State Registration No. 934
or Agency

Certified Cor. Record Prepared ? Yes No Filed At: _____ Date _____

REMARKS

Index File No. E-10 T. 1 S R. 36 E M. WILL. Tract or Surv. No. _____ Cor. _____