

Index
File No. N-13

CORNER RECORD (SEARCH)


(Ref. FSM 7151.4)

Tract or
Survey No. N 13 Cor. No. 46 Sec. 36

T 1 S R. 36 E R.D. Pendleton County Umatilla

Merid. Willamette N.F. Umatilla State Oregon

CORNER DIAGRAM

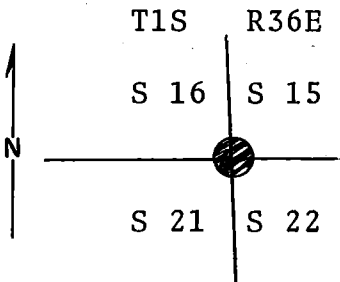

DESCRIBE CORNER MONUMENT FOUND

Brass cap set summer 1972. See reverse side.

DESCRIBE BEARING TREES OR OTHER OFFICIAL ACCESSORIES FOUND

Found a 30" pine, live in good condition, with scribing visible.

PHOTO IDENTIFICATION DATA

Photo No. _____
Filed At. _____
Object Ident. _____
Ident. By _____

Signature

PLANE COORDINATE POSITION DATA

State _____ Zone _____
X _____
Y _____
Estab. By _____

Agency

DESCRIBE CORNER LOCATION RELATIVE TO NEAR-BY FEATURES, ALSO HOW TO REACH CORNER

Established corner position N25°W 128 ft. dist from tree.



Signature

Title

Division

Headquarters

Date

7100-52 (3/68)

CORNER RECORD (PERPETUATION)

MONUMENT: DESCRIBE NEW MONUMENT SET, OR WORK DONE TO PRESERVE EXISTING MONUMENT

Set a 30x2½" iron pipe with 3" brass cap marked as shown, 25" in ground and raised a mound of stone around the pipe for the corner to sections 15, 16, 21 & 22, from which new BTs:

ACCESSORIES : DESCRIBE NEW BT's WITNESS OBJECTS ETC. ESTABLISHED, OR WORK DONE TO PRESERVE EXISTING EVIDENCE

A 16" pine bears N2°E 311.8 ft. dist. marked T1S R36E S15 BT.
A 14" fir bears S35°W 72.0 Ft. dist. marked T1S R36E S16 BT.
A 14" fir bears N52°W 84.3 ft. dist. marked T1S R36E S16 BT.
Distances taken to a brass washer in the blaze each tree.
Set a steel post approx. 5' North of corner with "Attention" sign attached.
Used a steel tape and magnetic compass with declination = 20° E.

Work Done By D. M. Ferguson Title Land Surveyor Date 7/12/69 State Registration No. 848
or Agency
Certified Cor. Record Prepared ? Yes No Filed At: Umatilla Co. Courthouse Date 11/16/72

REMARKS