

Index
File No. N-08

CORNER RECORD (SEARCH)
(Ref. FSM 7151.4)

Tract or
Survey No. _____
Cor.
No. _____


T 1 S R. 36 E

R.D. WALLA WALLA County UMATILLA

Merid. W. M

N.F. UMATILLA State OREGON

CORNER DIAGRAM

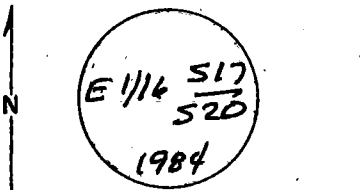

DESCRIBE CORNER MONUMENT FOUND

BLM BRASS CAP RISING 3" ABOVE
GROUND

PHOTO IDENTIFICATION DATA

Photo No. _____
Filed At. _____
Object Ident. _____
Ident. By _____
Signature

DESCRIBE BEARING TREES OR OTHER OFFICIAL ACCESSORIES FOUND

16" FIR, BLAZED & SCRIBED E 1/16 S 17 BT,
BEARS N 73 1/2° W - 23 LKS - 15.2 FT.
9" FIR, BLAZED & SCRIBED E 1/16 S 20 BT
BEARS S 3 1/2° W - 58 1/2 LKS - 38.6 FT.

PLANE COORDINATE POSITION DATA

State _____ Zone _____
X _____
Y _____
Estab. By _____
Agency

DESCRIBE CORNER LOCATION RELATIVE TO NEAR-BY FEATURES, ALSO HOW TO REACH CORNER

ON SOUTH WEST SLOPE ROAD 3102-020
2 MILES THEN N FROM LOCATION POSTER
ON 12" FIR, WALK EAST 600 FT TO
CORNER

Signature
D. L. Coate

Title LS 1844 Division _____ Headquarters _____ Date 7-9-85
FS-7100-52 (3/68)

CORNER RECORD (PERPETUATION)

MONUMENT: DESCRIBE NEW MONUMENT SET, OR WORK DONE TO PRESERVE EXISTING MONUMENT

NONE

ACCESSORIES : DESCRIBE NEW BT'S WITNESS OBJECTS ETC. ESTABLISHED, OR WORK DONE TO PRESERVE EXISTING EVIDENCE

SET STEEL FENCE POST
ATTACHED SIGNS TO POST & BT'S

Work Done By D.E. SCOTT Title SURVEYOR Date 7-9-85 State Registration No. LS 1844
or Agency

Certified Cor. Record Prepared? Yes No Filed At:

Date

REMARKS

Index File No.

N-08

T.

15

R.

36E

WM.

Tract or Surv. No.

E 1/16 Cor. 517
3 20.