

Index File No. X-1

CORNER RECORD (SEARCH)

(Ref. FSM 7151.4)

Tract or Survey No. _____

Cor. No. _____

T 15 R. 36E

R.D. WALLA WALLA


County UMATILLA

Merid. WILLAMETTE

N.F. UMATILLA

State OREGON

CORNER DIAGRAM

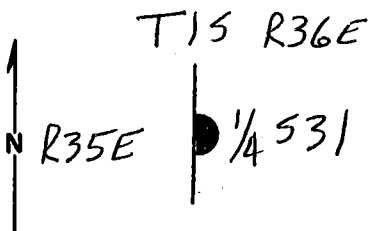

DESCRIBE CORNER MONUMENT FOUND

1 1/2" IRON PIPE & BRASS CAP MARKED;
OREGON STATE BOARD OF FORESTRY

1/4 S31 1969 RS 359
WHITE WOOD POST 2 FT SW

DESCRIBE BEARING TREES OR OTHER OFFICIAL ACCESSORIES FOUND

SCRIBES:

19" FIR S14°W, 35.0ft. " 1/4 S31 BT RS 359"

14" FIR S10°E, 42.1ft " 1/4 S31 BT"

PHOTO IDENTIFICATION DATA

Photo No. _____

Filed At. _____

Object Ident. _____

Ident. By _____

Signature

PLANE COORDINATE POSITION DATA

State _____ Zone _____

X _____

Y _____

Estab. By _____

Agency

DESCRIBE CORNER LOCATION RELATIVE TO NEAR-BY FEATURES, ALSO HOW TO REACH CORNER

Signature
JOHN HOLLINGSWORTH

Title

LS 691

Division

Headquarters
SALEM

Date

3-82

FS-7100-52 (3/68)

CORNER RECORD (PERPETUATION)

MONUMENT: DESCRIBE NEW MONUMENT SET, OR WORK DONE TO PRESERVE EXISTING MONUMENT

9

ACCESSORIES : DESCRIBE NEW BT'S WITNESS OBJECTS ETC. ESTABLISHED, OR WORK DONE TO PRESERVE EXISTING EVIDENCE

10

Work Done By _____ Title _____ Date _____ State Registration No. or Agency _____

Certified Cor. Record Prepared ? Yes No Filed At: _____ Date _____

11

REMARKS

12

Index File No. T. R. M. Tract or Surv. No. Cor.

13