


**CERTIFIED RECORD OF LAND CORNER MONUMENTATION**

**HISTORY OF ORIGINAL CORNER ESTABLISHMENT:**

Corner not originally established.

T 1 S R 36 E Z-12

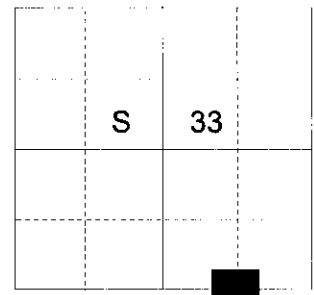

**DESCRIPTION OF CORNER EVIDENCE FOUND:**

None.

**DESCRIPTION OF MONUMENT AND ACCESSORIES I ESTABLISHED TO PERPETUATE THE ORIGINAL LOCATION OF THIS CORNER:**

At the position determined by survey, I set a 5/8" x 30" rebar with 2 1/2" aluminum cap, marked as shown below, 29 inches in the ground, from which:

A 5 inch Ponderosa Pine bears South 81° West, a distance of 4.90 feet, marked E 1/16 S4 BT.


A 6 inch Ponderosa Pine bears North 26° West, a distance of 21.95 feet, marked E 1/16 S33 BT.

I hereby certify that the corner was monumented on November 7, 2012.

REGISTERED  
PROFESSIONAL  
LAND SURVEYOR

*[Signature]*  
OREGON  
June 2, 2010  
JEFFERY S. HSU  
83571

Renewal Date: June 30, 2013

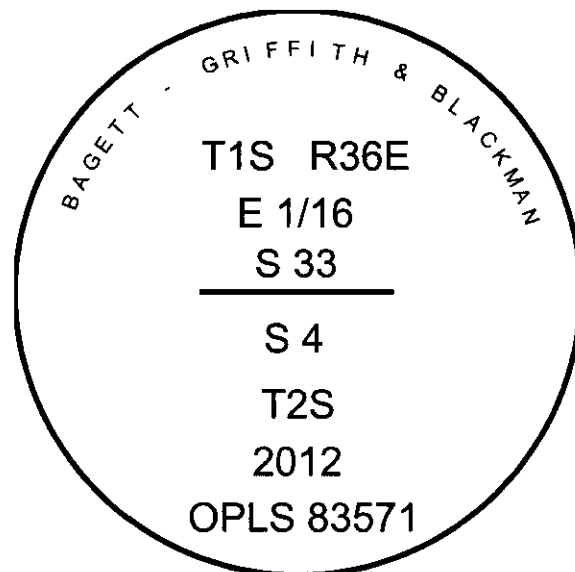

**RECEIVED BY**

Umatilla County Surveyor

Date: 12/14/2012

Rec'd By: J. P. [Signature]

No.: 12-144-13

I used a steel tape and magnetic compass in the establishment of new trees. I used 16° East magnetic declination. Distance is to a 60d spike in the right hand side of the trees. Bearing is to a brass washer marked OPLS 83571 in the lower BT blaze.