

USDA-FOREST SERVICE

Index
File No. A-15

CORNER RECORD (SEARCH)

(Ref. FSM 7151.4)

Tract or
Survey No. _____
Cor.
No. _____


T 15 R. 37E

R.D. WALLA WALLA County UMATILLA

Merid. Will

N.F. UMATILLA State OREGON

CORNER DIAGRAM

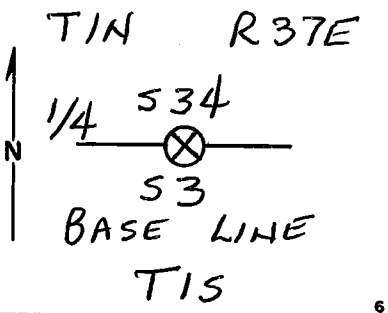

DESCRIBE CORNER MONUMENT FOUND

NONE - THIS IS THE TIMOTHY DAVENPORT CORNER SET IN 1863 AND SUPERSEDED BY THE 1882 GRADON SURVEY.

DESCRIBE BEARING TREES OR OTHER OFFICIAL ACCESSORIES FOUND

ORIG. 16" TAMARACK IS NOW A SAWN STUMP, I OPEN HEALED BLAZE AND FIND THE FACE CHOPPED OUT BY GRADON IN 1882. THERE ARE FRAGMENTARY SCRIBES & REVERSE SCRIBES STILL VISIBLE. BEARS 515°E, 42.9ft. ORIGINAL 10" RED FIR IS GONE.

DESCRIBE CORNER LOCATION RELATIVE TO NEAR-BY FEATURES, ALSO HOW TO REACH CORNER

I PUT A LOCATION POSTER ON A 24" PONDEROSA PINE ON THE EAST EDGE OF ROAD 3116 & 50 feet EAST OF THE CORNER.

PHOTO IDENTIFICATION DATA

Photo No. _____
Filed At. _____
Object Ident. _____
Ident. By _____
Signature

PLANE COORDINATE POSITION DATA

State _____ Zone _____
X _____
Y _____
Estab. By _____
Agency

Signature Dennis L. Gaylord Title PLS Division 1636 Headquarters S.O. Date 7-17-86
FS-7100-52 (3/68)

CORNER RECORD (PERPETUATION)

MONUMENT : DESCRIBE NEW MONUMENT SET, OR WORK DONE TO PRESERVE EXISTING MONUMENT

9

ACCESSORIES : DESCRIBE NEW BT's WITNESS OBJECTS ETC. ESTABLISHED, OR WORK DONE TO PRESERVE EXISTING EVIDENCE

10

Work Done By. _____ Title _____ Date _____ State Registration No. or Agency _____

Certified Cor. Record Prepared ? Yes No Filed At: _____ Date _____

11

REMARKS

12

Index File No. T. R. M. Tract or Surv. No. Cor. _____

13