

USDA-FOREST SERVICE


Index
File No. X-9
T LS R. 37E
Merid. Will

CORNER RECORD (SEARCH)

(Ref. FSM 7151.4)

Tract or Survey No. _____ Cor. No. _____
R.D. LA GRANDE County UNION
N.F. WALDOBIA - WHITMAN State OREGON

CORNER DIAGRAM

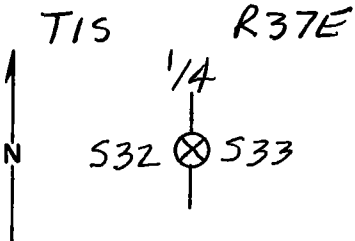

DESCRIBE CORNER MONUMENT FOUND

MOUND OF STONES. NONE OF RECORD SIZE. ALL ARE SMALLER & APPEAR BROKEN.

DESCRIBE BEARING TREES OR OTHER OFFICIAL ACCESSORIES FOUND

ORIG. 18" NOW 24" DOUGLAS FIR WITH A HEALED UPPER BLAZE, LOWER BLAZE IS IN BARK ONLY. BEARS N 63° W, 15.2 FT.

ORIG 7" FIR TO NE IS GONE.

PUT B.T. SIGN ON 24" B.T.

DESCRIBE CORNER LOCATION RELATIVE TO NEAR-BY FEATURES, ALSO HOW TO REACH CORNER
ON POINT OF SMALL RIDGE SLOPING WEST & BETWEEN TWO SMALL CREEKS.

PHOTO IDENTIFICATION DATA

Photo No. _____
Filed At. _____
Object Ident. _____
Ident. By _____
Signature _____

PLANE COORDINATE POSITION DATA

State _____ Zone _____
X _____
Y _____
Estob. By _____
Agency _____

Signature Dennis L. Hayford Title _____ Division LS 1636 Headquarters S.O. (Lamberton) Date 6-7-88

CORNER RECORD (PERPETUATION)

MONUMENT : DESCRIBE NEW MONUMENT SET, OR WORK DONE TO PRESERVE EXISTING MONUMENT

9

ACCESSORIES : DESCRIBE NEW BT'S WITNESS OBJECTS ETC. ESTABLISHED, OR WORK DONE TO PRESERVE EXISTING EVIDENCE

10

Work Done By _____ Title _____ Date _____ State Registration No.
or Agency _____

Certified Cor. Record Prepared ? Yes No Filed At: _____ Date _____

11

REMARKS

12

Index File No. T. R. M. Tract or Surv. No. Cor. _____

13