

USDA-FOREST SERVICE

Index File No. A-25

CORNER RECORD (SEARCH)

(Ref. FSM 7151.4)

Tract or Survey No. _____

Cor. No. _____


T 1S R. 37E

R.D. WALLA WALLA County UMATILLA-UNION COUNTY LINE

Merid. WILL

N.F. UMATILLA State OREGON

CORNER DIAGRAM

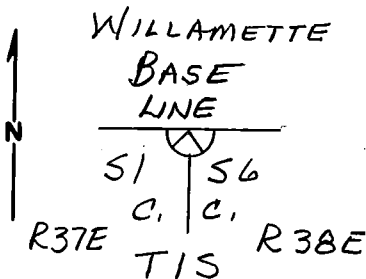

DESCRIBE CORNER MONUMENT FOUND

NONE

DESCRIBE BEARING TREES OR OTHER OFFICIAL ACCESSORIES FOUND

ORIG. 8" SPRUCE IS A 24" LIVE LODGEPOLE PINE PREVIOUSLY OPENED FAINT SCRIBES ARE VISIBLE. BEARS N 40°W, 16.5 FT.

ORIG. 8" SPRUCE IS NOW ONLY A DELAYED PIECE OF WOOD WITH SCRIBING, "BT", VISIBLE. BEARS N 60°E, 15.8 FT.

ORIG. 16" SPRUCE IS A 24" SPRUCE WINDFALL WITH FULL SCRIBES VISIBLE ON PARTLY HEALED DOUBLE BLAZES, BEARS S 30°W, 51.5 FT. ORIG. SE BT IS GONE!

DESCRIBE CORNER LOCATION RELATIVE TO NEAR-BY FEATURES, ALSO HOW TO REACH CORNER

CORNER IS 1,100 FT WEST OF SUMMIT RD. 31. PLACED BT SIGNS ON TREES & K-TAG ON RD 31. (CORNER IS AT SE TIP OF GLADE)

PHOTO IDENTIFICATION DATA

Photo No. _____
 Filed At. _____
 Object Ident. _____
 Ident. By _____
 Signature _____

PLANE COORDINATE POSITION DATA

State _____ Zone _____
 X _____
 Y _____
 Estab. By _____
 Agency _____

Signature

Title

Division

Headquarters

Date

7100-52-(3-68)

Dennis L. Gaylord

PLS 1636

9/30/81

CORNER RECORD (PERPETUATION)

MONUMENT : DESCRIBE NEW MONUMENT SET, OR WORK DONE TO PRESERVE EXISTING MONUMENT

ACCESSORIES : DESCRIBE NEW BT'S WITNESS OBJECTS ETC. ESTABLISHED, OR WORK DONE TO PRESERVE EXISTING EVIDENCE

Work Done By _____ Title _____ Date _____ State Registration No. _____
or Agency _____
Certified Cor. Record Prepared ? Yes No Filed At _____ Date _____

REMARKS

Index File No. T. R. M. Tract or Surv. No. Cor.

Index
File No. A-25

CORNER RECORD (SEARCH)

(Ref. FSM 7151.4)

Tract or
Survey No. _____ Cor.
No. _____


T IS R. 37E

R.D. WALLA-WALLA County Umatilla - Union County line

Merid. Willamette

N.F. Umatilla State Oregon

CORNER DIAGRAM

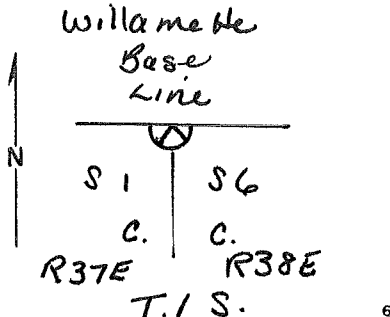

DESCRIBE CORNER MONUMENT FOUND

None - see Remarks other side

DESCRIBE BEARING TREES OR OTHER OFFICIAL ACCESSORIES FOUND

Orig. 8" spruce is a 24" live hPP previously opened. Faint scribes are visible. Bears N. 40W., 16.5 ft.

Orig. 8" spruce is now only a decayed piece of wood with scribing, "B.T." visible. Bears N 60°E, 15.8 ft.

Orig. spruce 16" is a 24" spruce windfall with full scribes, visible on partly healed double blazes, bears S 30°W, 51.5 ft. Orig SE BT is gone.

PHOTO IDENTIFICATION DATA

Photo No. _____
Filed At. _____
Object Ident. _____
Ident. By _____
Signature

DESCRIBE CORNER LOCATION RELATIVE TO NEAR-BY FEATURES, ALSO HOW TO REACH CORNER

Corner is 1100 ft. West of Summit Rd. #31.

Placed BT signs on trees & K-Tag. on Rd 31.
(Corner is at SE Tip of glade.)

PLANE COORDINATE POSITION DATA

State _____ Zone _____
X _____
Y _____
Estab. By _____
Agency

Signature
Dennis L Gaylord

Title
PLS 1636

Division
Umatilla NF

Headquarters
9/30/81

Date
7100-52-(3,68)

4

5

CORNER RECORD (PERPETUATION)

MONUMENT: DESCRIBE NEW MONUMENT SET, OR WORK DONE TO PRESERVE EXISTING MONUMENT

9

ACCESSORIES : DESCRIBE NEW BT'S WITNESS OBJECTS ETC. ESTABLISHED, OR WORK DONE TO PRESERVE EXISTING EVIDENCE

10

Work Done By _____ Title _____ Date _____ State Registration No. or Agency _____

Certified Cor. Record Prepared? Yes No Filed At: _____ Date _____

REMARKS

Corner monumented by BLM in 2003. See card A-1 in file for T1SR38E

12

Index File No. T. R. M. Tract or Surv. No. Cor. 13

USDA-FOREST SERVICE

Index
File No. A-1

CORNER RECORD (SEARCH)

(Ref. FSM 7151.4)

Tract or
Survey No. _____
Cor. No. CC 1 & 6


T 15 R. 3BE

R.D. La Grande County Union

Merid. Will.

N.F. W-W State Oregon

CORNER DIAGRAM

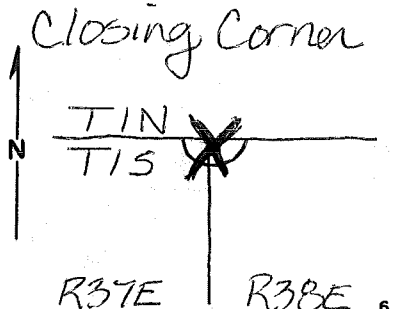

DESCRIBE CORNER MONUMENT FOUND

None

DESCRIBE BEARING TREES OR OTHER OFFICIAL ACCESSORIES FOUND 2

Found everything Gaylord found in 1981.
ORIG. NW & SW, NE B.T.

PHOTO IDENTIFICATION DATA

Photo No. _____
Filed At. _____
Object Ident. _____
Ident. By _____
Signature 7

DESCRIBE CORNER LOCATION RELATIVE TO NEAR-BY FEATURES, ALSO HOW TO REACH CORNER 3

String-boxed 1100 ft. west from k-tag
on Road 31.

PLANE COORDINATE POSITION DATA

State _____ Zone _____
X _____
Y _____
Estab. By _____
Agency 8

Signature

Title

Division

Headquarters

Date

FS-7100-52 (3/68) 4

Archie Redino Miller Tech. *LL.L.* *GREZ* *9-92* 5

CORNER RECORD (PERPETUATION)

MONUMENT: DESCRIBE NEW MONUMENT SET, OR WORK DONE TO PRESERVE EXISTING MONUMENT

None

ACCESSORIES: DESCRIBE NEW BT'S WITNESS OBJECTS ETC. ESTABLISHED, OR WORK DONE TO PRESERVE EXISTING EVIDENCE

Painted scribing rod on the NW & SW B.T.s. Put Land Survey monument signs on NW & SW B.T.s. Placed a Monument sign on nearby tree by NE B.T.

Work Done By H. Hendrix Miller Title Survey Tech. Date 9-92 State Registration No. or Agency _____

Certified Cor. Record Prepared? Yes No Filed At _____ Date _____

REMARKS

Earl Strong

Index File No. A-1 T. 13 R. 38E M. Will. Tract or Surv. No. _____ Cor. CC 196

CORNER RECORD (PERPETUATION)

MONUMENT: DESCRIBE NEW MONUMENT SET, OR WORK DONE TO PRESERVE EXISTING MONUMENT

Set stainless steel post, 28" long, 2 1/2" diam, 20" in the ground, in a mound of stone, with brass cap. Deposit white magnet at base of post.

ACCESSORIES : DESCRIBE NEW BT'S WITNESS OBJECTS ETC. ESTABLISHED, OR WORK DONE TO PRESERVE EXISTING EVIDENCE 9

22" Tamarack bears S 31 1/4° E, 85.0' scribed T15 R38E S6 CC BT
 9" Fir bears S 44° W, 19.5' scribed T15 R37E S1 CC BT
 12" LP Pine bears N 14 1/4° W, 33.4' scribed X BT

Distance measured to 2 1/2" x 1/4" Mag Nail on right side center

Work Done By B Seibold Title Cap. Sur. Date 2003 State Registration No. BLM
 or Agency

Certified Cor. Record Prepared? Yes No Filed At: _____ Date _____

11

REMARKS

Index File No. T. R. M. Tract or Surv. No. Cor. 12

A-1 15 - 38E Will 13